

MISSISSIPPI DEPARTMENT OF NATURAL RESOURCES

Bureau of Land and Water Resources

Southport Mall

P.O. Box 10631

Jackson, Mississippi 39209

WATER WELL DRILLERS LOG

PEARL RIVER  
J 2028

8-5-86

19

86

Walkers Molding

Pearl River

date well completed

firm name

county well located

LANDOWNER: 100" Corbin

description of formations encountered

from

to

(mailing address)

125' White clay

0

125'

Blue clay

125'

135'

Gray sand

135'

175'

WELL LOCATION:

sec. 26 43 N R 18 E

20 miles NW of Picayune  
(distance) (direction) (nearest town)

WELL PURPOSE: Home  
(home, irrigation, municipal, industrial)

WELL COMPLETION DATA:

- (1) diameter (inches) 1 1/2"
(2) total depth (feet) 275'
(3) static water level (feet) 70' below top of ground.

(4) casing PVC 1608'
(material) (depth)

(size) if telescope see back.

(5) screen 10" 160"
(length) (depth to top)

#10 PVC
(size) (material)

(6) pump 1/2 8gpm
(HP) (yield gpm)


(type power)

(7) electric log (yes or no)

(organization running log)

(8) how well bottom plugged
Sand shrimp


DRILLERS REMARKS:

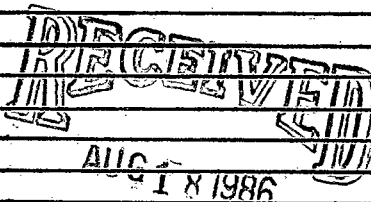

Department of Natural Resources
Bureau of Land & Water Resources

If well telescopes please sketch and show depths.

GROUND LEVEL

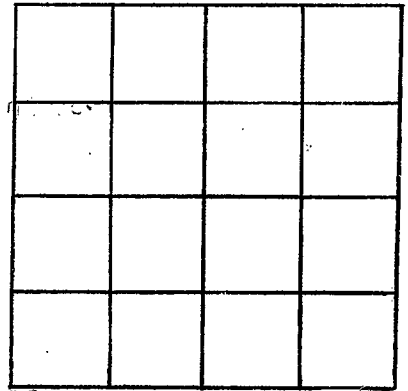

SECTION \_\_\_\_\_

Please indicate well location X.

ADDITIONAL INFORMATION

If more than one screen,  
show locations of each on sketch.