

MISSISSIPPI DEPARTMENT OF NATURAL RESOURCES

Bureau of Land and Water Resources

Southport Mall

P.O. Box 10631

Jackson, Mississippi 39209

WATER WELL DRILLERS LOG

PEARL RIVER
J 2027

NOV
date well completed

1986 CLEAR WATER
firm name

PEARL RIVER
county well located

LANDOWNER: PAT Amakov

Cross Road

MS 39976
(mailing address)

WELL LOCATION:

sec. 4 T. 3 N. R. 18 E. J.
8 miles NW of Boylston
(distance) (direction) (nearest town)

WELL PURPOSE:

(home, irrigation, municipal, industrial)

WELL COMPLETION DATA:

- (1) diameter (inches) 2"
- (2) total depth (feet) 32
- (3) static water level (feet) 9 below above top of ground.
- (4) casing PVC 22
(material) (depth)
 if telescope see back.
(size)
- (5) screen 10 22
(length) (depth to top)
014 PVC STAT
(size) (material)
- (6) pump
(HP) (yield gpm)

(type power)
- (7) electric log
(yes or no)

(organization running log)
- (8) how well bottom plugged SS

description of formations encountered

from

to

<u>Top Soil</u>	<u>0</u>	<u>9"</u>
<u>Sand</u>	<u>9'</u>	<u>25'</u>
<u>Gravel & Sand</u>	<u>15</u>	<u>38</u>
<u>tan clay</u>	<u>38</u>	<u>44</u>
<u>white sands & gravel</u>	<u>44</u>	<u>70</u>

RECEIVED


NOV 21 1986

Department of Natural Resources
Bureau of Land & Water Resources

DRILLERS REMARKS:

If well telescopes please
sketch and show depths.

GROUND LEVEL

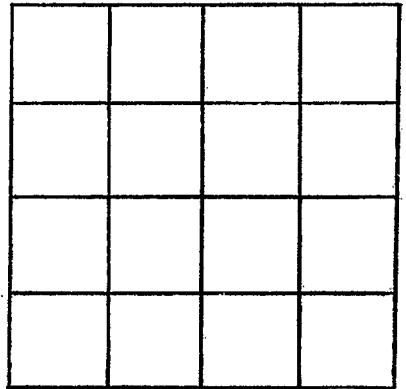

SECTION _____

Please indicate well location X.

ADDITIONAL INFORMATION

If more than one screen,
show locations of each on sketch.