

MISSISSIPPI DEPARTMENT OF NATURAL RESOURCES

Bureau of Land and Water Resources

P.O. Box 10631

Jackson, Mississippi 39209

WATER WELL DRILLERS LOG

COUNTY WELL LOCATED PEARL RIVER	
WELL NUMBER J	CODED
2035	
DATE WELL COMPLETED	

PERMIT NUMBER 0.428
NAME OF DRILLING FIRM WALKER WELL DRILLING

NAME & MAILING ADDRESS OF LANDOWNER ROY SMITH CROSS ROAD			
WELL LOCATION: SEC	TOWNSHIP	RANGE	
9	B	18	W
DISTANCE	DIRECTION	NEAREST TOWN	
4 Miles	N	CROSSROADS	
OTHER LANDMARK			
WELL PURPOSE (Home Irrigation, Municipal, Industrial, Fish Pond, etc.) CAMP			

PUMP DATA		
PUMP TYPE (Circle One): Submersible, Turbine, Jet, Flowing Well, Other (Describe) _____		
POWER TYPE (Circle One): Electric, Tractor, Diesel, Gasoline, Butane, Other (Describe) _____		
Pump Capacity (GPM)	No. of Stages	Setting Depth FT.
PUMP TEST		
Well yielded _____ GPM with a drawdown of _____ ft. after _____ hours of pumping		

WELL DATA		
Well Depth 540'	Casing Diameter (In.) 2"	Casing Length (Ft.) 520
Type of Casing PVC	Hole Depth 540	Depth to Static Water Level 0 FLOWS
TYPE OF COMPLETION: (Circle One or More): Gravel Packed, Underreamed, Telescoped, Natural Development, Open Hole, Other (Describe) WATER		
Top of Lap Pipe or Reduction in Casing FEET IF TELESCOPED OR MORE THAN ONE SCREEN: USE BACK PAGE		

LOG DATA	
TYPE OF LOG RUN (Circle One): Electric, Gamma Ray, Density, Sonic, Neutron, Other (Describe) _____	
Name of Organization Running Log	

SCREEN DATA		
Diameter - Inches 2"	Length - Feet 20'	Slot Size - Inches #10
Screen Type SHOT		Depth to Bottom - Feet 540


GEOLOGIC DATA (Office Use Only)			
Surface Elev.	Geologic Unit	Unit Thickness	Depth to Top
Subs. SWL	Date	Analysis	Aquifer Test
Driller's Remarks			

DESCRIPTION OF FORMATIONS ENCOUNTERED	FROM	TO	FORMATIONS (Continued)	FROM	TO
CLAY	0	10	<div style="font-size: 2em; font-weight: bold; opacity: 0.5;">RECEIVED</div> <div style="font-size: 1.2em; font-weight: bold;">NOV 22 1983</div> <div style="font-size: 0.8em;">Department of Natural Resources Bureau of Land & Water Resources</div>		
SAND	10	25			
ROCKS	25	90			
CLAY	90	120			
SAND	120	150			
CLAY	150	200			
SAND	200	250			
CLAY	250	300			
SAND	300	350			
CLAY	350	400			
SAND	400	540			

IF MORE SPACE IS NEEDED, USE BACK

If well telescopes please sketch and show depths.

GROUND LEVEL

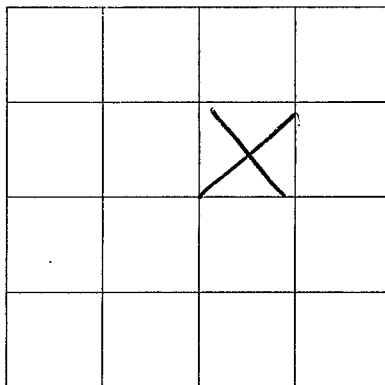

SECTION _____

Please indicate well location X.

ADDITIONAL INFORMATION

If more than one screen,
show location of each on sketch.