

MISSISSIPPI DEPARTMENT OF NATURAL RESOURCES

Bureau of Land and Water Resources

P.O. Box 10631

Jackson, Mississippi 39209

WATER WELL DRILLERS LOG

COUNTY WELL LOCATED P. River		PERMIT NUMBER
WELL NUMBER 5	CODED	
2036		NAME OF DRILLING FIRM WALKER SWELL DRILLING
DATE WELL COMPLETED 12-10-88		

NAME & MAILING ADDRESS OF LANDOWNER

DANA Bowen

RT 1 Box 235

Acme, MS.

WELL LOCATION: SEC	TOWNSHIP	RANGE
36	3	18
DISTANCE	DIRECTION	NEAREST TOWN
12 Miles	NW	of PICAUNE

OTHER LANDMARK

WELL PURPOSE: Home Irrigation, Municipal, Industrial, Fish Pond, etc.

PUMP DATA		
PUMP TYPE (Circle One): Submersible, Turbine, <input checked="" type="checkbox"/> Jet, <input type="checkbox"/> Flowing Well, Other (Describe) _____		
POWER TYPE (Circle One): <input checked="" type="checkbox"/> Electric, <input type="checkbox"/> Tractor, <input type="checkbox"/> Diesel, <input type="checkbox"/> Gasoline, <input type="checkbox"/> Butane, Other (Describe) _____		
Pump Capacity (GPM) 12	No. of Stages 2	Setting Depth 60 FT.
PUMP TEST		
Well yielded _____ GPM with a drawdown of _____ ft. after _____ hours of pumping		

WELL DATA		
Well Depth 116	Casing Diameter (In.) 2"	Casing Length (Ft.) 101
Type of Casing PUC	Hole Depth 116	Depth to Static Water Level 35
TYPE OF COMPLETION: (Circle One or More): Gravel Packed, Underreamed, Telescoped, Natural Development, Open Hole, Other (Describe) AIR		
Top of Lap Pipe or Reduction in Casing FEET <input type="checkbox"/> IF TELESCOPED OR MORE THAN ONE SCREEN: USE BACK PAGE		

LOG DATA	
TYPE OF LOG RUN (Circle One): No Log Run, Electric, Gamma Ray, Density, Sonic, Neutron, Other (Describe) _____	
Name of Organization Running Log	

SCREEN DATA		
Diameter - Inches 2	Length - Feet 15	Slot Size - Inches #10 & #8
Screen Type SCOT WRAP	Depth to Bottom - Feet 116	

GEOLOGIC DATA (Office Use Only)			
Surface Elev.	Geologic Unit	Unit Thickness	Depth to Top
Subs. SWL	Date	Analysis	Aquifer Test

Driller's Remarks

DESCRIPTION OF FORMATIONS ENCOUNTERED	FROM	TO
CLAY	0	10
SAND	10	20
CLAY	20	30
SAND	30	50
CLAY	50	60
SAND	60	116

RECEIVED

FEB 8 1989


Department of Natural Resources
Bureau of Land & Water Resources

FORMATIONS (Continued)	FROM	TO

IF MORE SPACE IS NEEDED, USE BACK

If well telescopes please sketch and show depths.

GROUND LEVEL

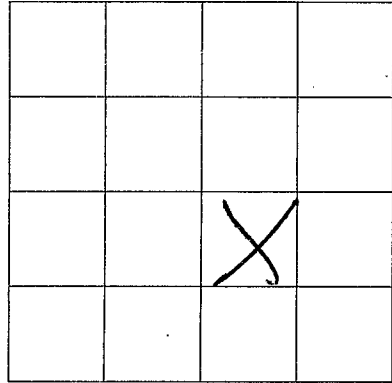

SECTION _____

Please indicate well location X.

ADDITIONAL INFORMATION

If more than one screen,
show location of each on sketch.