

MISSISSIPPI DEPARTMENT OF NATURAL RESOURCES

Bureau of Land and Water Resources

Southport Mall

P.O. Box 10631

Jackson, Mississippi 39209

WATER WELL DRILLERS LOG

P. RIVER
J 2037

Aug 10 1958 Clear Water Drillers Inc. Pearl River
date well completed firm name county well located

LANDOWNER: T.P. Wheat
Rt 1 Box 292
Pearl River Ms. 38870
(mailing address)

WELL LOCATION:
sec. 13 T 2 N R 12 E
(S) (W)
12 miles W of Pearl River
(distance) (direction) (nearest town)

WELL PURPOSE: Home
(home, irrigation, municipal, industrial)

- WELL COMPLETION DATA:
- (1) diameter (inches) 9"
 - (2) total depth (feet) 120'
 - (3) static water level (feet) 50 below top of ground.
 - (4) casing PVC 110 (material), (depth)
(size) if telescope see back.
 - (5) screen 10' 110' (length), (depth to top)
012 PVC S60TT (size), (material)
 - (6) pump 1 20 (HP), (yield gpm)
220V (type power)
 - (7) electric log (yes or no)
(organization running log)
 - (8) how well bottom plugged 55

description of formations encountered	depth	
	from	to
top Soil	0	6"
tan sand & clay.	6	10'
tan to yellow clay.	10'	40
tan & Red Clay	40	80
Some Sand Red Clay	80	90
tan Red Clay	90	100'
med to coarse tan sand	100'	120


RECEIVED
FEB 10 1959

Department of Natural Resources
Bureau of Land & Water Resources

DRILLERS REMARKS:

If well telescopes please
sketch and show depths.

GROUND LEVEL

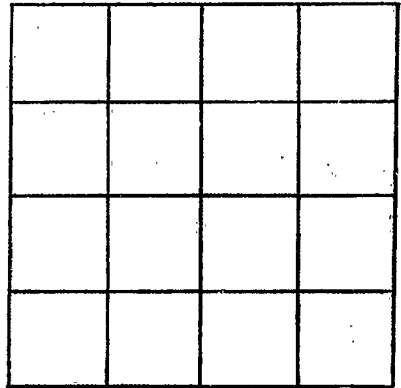

SECTION _____

Please indicate well location X.

ADDITIONAL INFORMATION

If more than one screen,
show locations of each on sketch.