

MISSISSIPPI DEPARTMENT OF NATURAL RESOURCES

Bureau of Land and Water Resources

P.O. Box 10631

Jackson, Mississippi 39209

WATER WELL DRILLERS LOG

COUNTY WELL LOCATED PEARL RIVER	
WELL NUMBER J	CODED
203A	
DATE WELL COMPLETED 3-10-89	

PERMIT NUMBER 0-428
NAME OF DRILLING FIRM WALKER WELL SERVICE

NAME & MAILING ADDRESS OF LANDOWNER			
HARVEY McMURRY			
CROSS ROAD MS. 39468			
WELL LOCATION: SEC	TOWNSHIP	RANGE	
23	3	N 18	E
DISTANCE	DIRECTION	NEAREST TOWN	
25 Miles	N	of PICAYUNE	
OTHER LANDMARK CROSS ROAD'S			
WELL PURPOSE: <u>Home</u> Irrigation, Municipal, Industrial, Fish Pond, etc.			

PUMP DATA		
PUMP TYPE (Circle One): <u>Submersible</u> , Turbine, Jet, Flowing Well, Other (Describe) _____		
POWER TYPE (Circle One): Electric, Tractor, Diesel, Gasoline, Butane, Other (Describe) _____		
Pump Capacity (GPM)	No. of Stages	Setting Depth FT.
PUMP TEST Well yielded _____ GPM with a drawdown of _____ ft. after _____ hours of pumping		

WELL DATA		
Well Depth 85	Casing Diameter (In.) 4	Casing Length (Ft.) 85
Type of Casing PVC	Hole Depth 90	Depth to Static Water Level 40
TYPE OF COMPLETION: (Circle One or More): Gravel Packed, Underreamed, Telescoped, <u>Natural Development</u> , Open Hole, Other		
(Describe) AIR		
Top of Lap Pipe or Reduction in Casing FEET IF TELESCOPED OR MORE THAN ONE SCREEN: USE BACK PAGE		

LOG DATA	
TYPE OF LOG RUN (Circle One): No Log Run, Electric, Gamma Ray, Density, Sonic, Neutron, Other (Describe) _____	
Name of Organization Running Log 	


SCREEN DATA		
Diameter - Inches 9	Length - Feet 10	Slot Size - Inches #12
Screen Type SLOT		Depth to Bottom - Feet 85

GEOLOGIC DATA (Office Use Only)			
Surface Elev.	Geologic Unit	Unit Thickness	Depth to Top
Subs. SWL	Date	Analysis	Aquifer Test
Driller's Remarks 			

DESCRIPTION OF FORMATIONS ENCOUNTERED	FROM	TO	FORMATION CONTINUED	
			FROM	TO
RED CLAY	0	25		
SAND	25	35		
GRAVEL	35	50		
SAND	50	85		
<div style="position: absolute; top: -50px; left: 50%; transform: translate(-50%, -50%); font-size: 2em; border: 1px solid black; padding: 5px;"> RECEIVED </div> <div style="position: absolute; top: -20px; left: 50%; transform: translate(-50%, -20%); font-size: 1.5em;"> MAY 11 1989 </div> <div style="text-align: center; font-size: 1.2em;"> Department of Natural Resources Bureau of Land & Water Resources </div>				
IF MORE SPACE IS NEEDED, USE BACK				

If well telescopes please sketch and show depths.

GROUND LEVEL

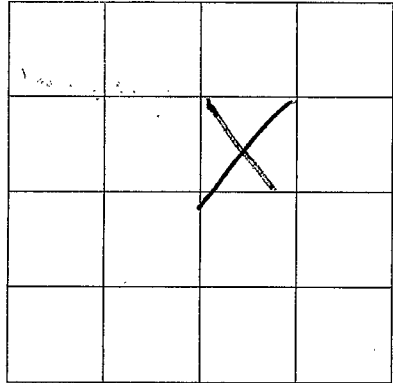

SECTION _____

Please indicate well location X.

ADDITIONAL INFORMATION

If more than one screen,
show location of each on sketch.