

MISSISSIPPI DEPARTMENT OF NATURAL RESOURCES

Bureau of Land and Water Resources

Southport Mall

P.O. Box 10631

Jackson, Mississippi 39209

WATER WELL DRILLERS LOG

P. River
J2041

8/17

date well completed

SP Badger & Son

firm name

Pearl River

county well located

LANDOWNER:

Mike Hines

description of formations encountered

from

to

148 Lake David

white sand gravel

0 62

Picayune

(mailing address)

Blue shale

62 285

gray sand

285 300

Blue shale

300 450

gray sand

450 567

Blue shale

567 604

Blue sand

604 620

Blue shale

620 840

gray sand

840 911

WELL LOCATION:


sec. 14 T 3 N R 18 E
15 miles West Poplarville (nearest town)

WELL PURPOSE:

home (home, irrigation, municipal, industrial)

WELL COMPLETION DATA:

- (1) diameter (inches) 2"
- (2) total depth (feet) 911
- (3) static water level (feet) 6 below top of ground.
- (4) casing PVC, 911 (material), (depth) if telescope see back.
- (5) screen 2x20, 881 (length), (depth to top) 12, PVC (size), (material)
- (6) pump NO (HP), (yield gpm) (type power)
- (7) electric log NO (yes or no)

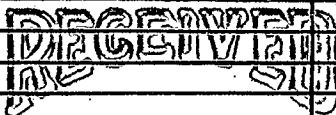

JAN 26 1990

Department of Natural Resources
Bureau of Land & Water Resources

(organization running log)

(8) how well bottom plugged

DRILLERS REMARKS:

NO pump furnished

