

MISSISSIPPI DEPARTMENT OF NATURAL RESOURCES

Bureau of Land and Water Resources

Southport Mall

P.O. Box 10631

Jackson, Mississippi 39209

WATER WELL DRILLERS LOG

P. Rivera  
T2043

9/21/89 date well completed  
S.P. Budington firm name  
Pear River county well located

LANDOWNER: Lyle Mackall  
R.T. 1 Box 176 Carrier  
Miss. (mailing address)

description of formations encountered  
~~Red shale~~  
~~White sand~~  
~~Blue shale~~

from to  
~~0 168~~  
~~168 280~~  
~~280 460~~  
460


WELL LOCATION:  
sec. 23 T. 3 N. R. 18 E.  
12 miles West of Carrier  
(distance) (direction) (nearest town)

Gray shale @ 168  
Red sand 168 280  
Blue shale 280 460  
Gray sand 460 508

WELL PURPOSE:  
(home, irrigation, municipal, industrial)

WELL COMPLETION DATA:

- (1) diameter (inches) 4
- (2) total depth (feet) 507
- (3) static water level (feet) 108 below top of ground.
- (4) casing PVC 307 (material) (depth)  
4X2 (size) if telescope see back.
- (5) screen 10 (length) 497 (depth to top)  
12 (size) PVC (material)
- (6) pump NO (HP) (yield gpm)  
(type power)
- (7) electric log NO (yes or no)

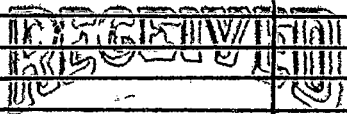

JAN 26 1990

DEPARTMENT OF NATURAL RESOURCES  
BUREAU OF LAND AND WATER RESOURCES

(organization running log)


(8) how well bottom plugged Sand  
Shale

DRILLERS REMARKS: no pump furnished

If well telescopes please sketch and show depths.

GROUND LEVEL

207 ft 2" / 200 ft - 4"

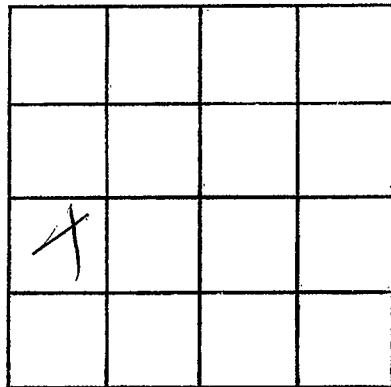

SECTION \_\_\_\_\_

Please indicate well location X.

ADDITIONAL INFORMATION

If more than one screen, show locations of each on sketch.