

MISSISSIPPI DEPARTMENT OF NATURAL RESOURCES

Bureau of Land and Water Resources

Southport Mall

P.O. Box 10631


Jackson, Mississippi 39209

WATER WELL DRILLERS LOG

P. R. U. G.  
J 2044

8/26 1989 Bud Penton, Inc Pearl River  
date well completed firm name county well located


LANDOWNER: <u>Miss Mari</u>	description of formations encountered	from	to
<u>Culture in RT. 1 Box</u>			
<u>2124 Carriere Miss.</u>	<u>sand &amp; gravel</u>	<u>16</u>	<u>26</u>
(mailing address)	<u>White shale</u>	<u>26</u>	<u>63</u>
WELL LOCATION:	<u>Blue sand &amp; gravel</u>	<u>63</u>	<u>189</u>
sec <u>34</u> T <u>3</u> N R <u>18</u> E (W)	<u>Blue shale</u>	<u>189</u>	<u>220</u>
<u>8</u> miles <u>West</u> Carriere	<u>Blue sand</u>	<u>220</u>	<u>315</u>
(distance) (direction) (nearest town)	<u>Blue shale</u>	<u>315</u>	<u>420</u>
WELL PURPOSE: <u>Industrial</u>	<u>Blue sand</u>	<u>420</u>	<u>504</u>
(home, irrigation, municipal, industrial)	<u>Blue shale</u>	<u>504</u>	<u>530</u>
WELL COMPLETION DATA:	<u>Blue sand &amp; gravel</u>	<u>530</u>	<u>660</u>
(1) diameter (inches) <u>4"</u>	<u>Blue shale</u>	<u>660</u>	<u>684</u>
(2) total depth (feet) <u>750</u>	<u>Gray sand</u>	<u>684</u>	<u>750</u>
(3) static water level (feet) <u>15 1/2</u> below top of ground.			
(4) casing <u>pvc</u> <u>750</u>			
(material) (depth)			
(size) if telescope see back.			
(5) screen <u>4x20</u> <u>730</u>			
(length) (depth to top)			
<u>12</u> <u>pvc</u>			
(size) (material)			
(6) pump (HP) (yield gpm)			
(type power)			
(7) electric log <u>no</u> (yes or no)			
(organization running log)			
(8) how well bottom plugged <u>Good</u>			
DRILLERS REMARKS:			

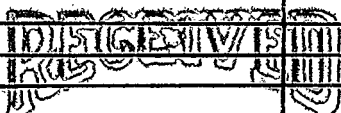

JAN 26 1990

If well telescopes please sketch and show depths.

GROUND LEVEL

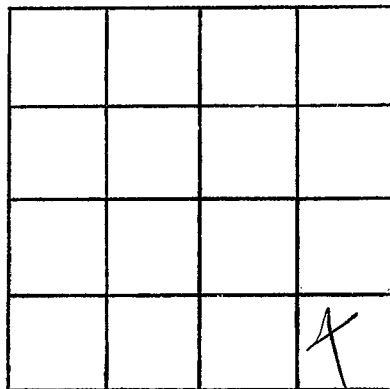

SECTION \_\_\_\_\_

Please indicate well location X.

ADDITIONAL INFORMATION

*[Faint, illegible text, possibly bleed-through from the reverse side of the page]*

If more than one screen,  
show locations of each on sketch.