

MISSISSIPPI DEPARTMENT OF NATURAL RESOURCES

Bureau of Land and Water Resources

Southport Mall

P.O. Box 10631


Jackson, Mississippi 39209

WATER WELL DRILLERS LOG

P. RIVER
J2045

1/30 1989 Bud Peterson Pearl River
date well completed firm name county well located

LANDOWNER: <u>Mrs. Marie</u>	description of formations encountered	from	to
<u>Culture inc. B.T. 1 Box</u>			
<u>212A Carriere miss.</u> (mailing address)	<u>sand + gravel</u>	<u>10</u>	<u>22</u>
	<u>Blue shale</u>	<u>22</u>	<u>30</u>
	<u>Blue sand</u>	<u>30</u>	<u>160</u>
	<u>Blue shale</u>	<u>160</u>	<u>230</u>
	<u>sand + gravel</u>	<u>230</u>	<u>240</u>
	<u>blue shale</u>	<u>240</u>	<u>255</u>
	<u>Blue sand</u>	<u>255</u>	<u>315</u>
	<u>Blue shale</u>	<u>315</u>	<u>465</u>
	<u>Blue sand</u>	<u>465</u>	<u>515</u>
WELL LOCATION: sec. <u>34</u> T. <u>3</u> N. <u>3</u> R. <u>18</u> E. <u>15</u> miles <u>NE</u> of <u>Carriere</u> (distance) (direction) (nearest town)			
WELL PURPOSE: <u>farm pond</u> (home, irrigation, municipal, industrial)			
WELL COMPLETION DATA:			
(1) diameter (inches) <u>6"</u>			
(2) total depth (feet) <u>515</u>			
(3) static water level (feet) <u>12</u> below above top of ground.			
(4) casing <u>pvc</u> , <u>515</u> (material) (depth) <u>6"</u> If telescope see back. (size)			
(5) screen <u>20</u> , <u>495</u> (length) (depth to top) <u>8</u> , <u>pvc</u> (size) (material)			
(6) pump <u>NO</u> (HP) (yield gpm) (type power)			
(7) electric log <u>NO</u> (yes or no) (organization running log)			
(8) how well bottom plugged <u>hard</u> <u>stone</u>			
DRILLERS REMARKS:			

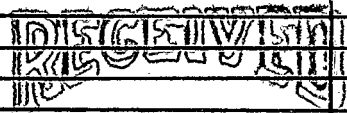

JAN 26 1990

DEPARTMENT OF NATURAL RESOURCES
BUREAU OF LAND & WATER RESOURCES

If well telescopes please sketch and show depths.


GROUND LEVEL

			9'

SECTION _____

Please indicate well location X.

ADDITIONAL INFORMATION

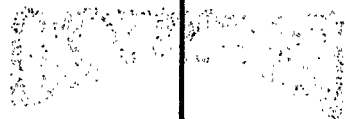

If more than one screen,
show locations of each on sketch.