

MISSISSIPPI DEPARTMENT OF NATURAL RESOURCES

Bureau of Land and Water Resources

Southport Mall

P.O. Box 10631

Jackson, Mississippi 39209

WATER WELL DRILLERS LOG


P. River
J 2046

8/23 1989
date well completed

Bud Penton & Son
firm name

Pearl River
county well located

LANDOWNER:	description of formations encountered	from	to
Miss. Mari Culture inc. RTI	White shale	0	10
Box 212A Carrier Miss (mailing address)	White Indigoni	10	20
	Blue shale	20	60
	Blue sand	60	190
	Blue shale	190	200
	Blue sand & ssgond	200	315
	Blue shale	315	480
	Gray sand	480	520
WELL LOCATION: sec. 34 T. 3 N R. 18 E 8 miles West of Carrier (distance) (direction) (nearest town)			
WELL PURPOSE: fish pond (home, irrigation, municipal, industrial)			
WELL COMPLETION DATA:			
(1) diameter (inches) 4"			
(2) total depth (feet) 520			
(3) static water level (feet) 124 below top of ground.			
(4) casing PVC 520 (material) (depth)			
(size) if telescope see back.			
(5) screen 12 x 20 520 (length) (depth to top)			
12 PVC (size) (material)			
(6) pump (HP) (yield gpm)			
(type power)			
(7) electric log no (yes or no)			
(organization running log)			
(8) how well bottom plugged Shard			
DRILLERS REMARKS:			

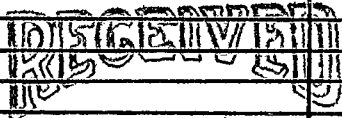


JAN 26 1990

Department of Natural Resources
Bureau of Land & Water Resources

If well telescopes please sketch and show depths.

GROUND LEVEL

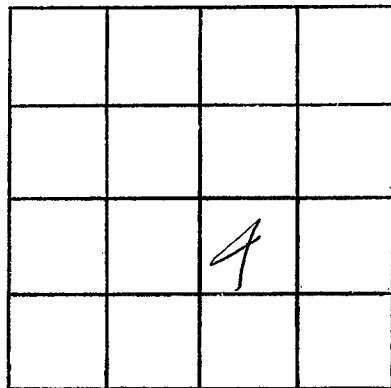

SECTION _____

Please indicate well location X.

ADDITIONAL INFORMATION

If more than one screen,
show locations of each on sketch.