

MISSISSIPPI DEPARTMENT OF NATURAL RESOURCES

Bureau of Land and Water Resources

P.O. Box 10631

Jackson, Mississippi 39209

WATER WELL DRILLERS LOG

COUNTY WELL LOCATED Peabel River	
WELL NUMBER 5	CODED
2047	
DATE WELL COMPLETED 12-5-89	

PERMIT NUMBER
NAME OF DRILLING FIRM M.C. Anthon Waterwell Lacombe, LA 70445

NAME & MAILING ADDRESS OF LANDOWNER WALTER Williams Rt. 3 Box 166-C Poplarville, Miss 39470		
WELL LOCATION: SEC	TOWNSHIP	RANGE
14	3	N 18 E
DISTANCE	DIRECTION	NEAREST TOWN
2 Miles	North	CROSSROADS
OTHER LANDMARK Inter. of old comp Rd & Humphreys Rd		
WELL PURPOSE: Home, Irrigation, Municipal, Industrial, Fish Pond, etc. HOME		

PUMP DATA ..		
PUMP TYPE (Circle One): Submersible, Turbine, Jet Flowing Well, Other (Describe) _____		
POWER TYPE (Circle One): Electric Tractor, Diesel, Gasoline, Butane, Other (Describe) _____ H/P _____		
Pump Capacity (GPM) 10	No. of Stages 1	Setting Depth surface FT.
PUMP TEST Well yielded 20 GPM with a drawdown of 15 ft. after 4 hours of pumping		

WELL DATA		
Well Depth 300	Casing Diameter (In.) 2	Casing Length (Ft.) 280
Type of Casing PVC	Hole Depth 300	Depth to Static Water Level 30
TYPE OF COMPLETION: (Circle One or More): Gravel Packed, Underreamed, Telescoped, Natural Development , Open Hole, Other (Describe) _____		
Top of Lap Pipe or Reduction in Casing n/a		
FEET IF TELESCOPED OR MORE THAN ONE SCREEN: USE BACK PAGE		

LOG DATA	
TYPE OF LOG RUN (Circle One): No Log Run , Electric, Gamma Ray, Density, Sonic, Neutron, Other (Describe) _____	
Name of Organization Running Log	



SCREEN DATA		
Diameter - Inches 2	Length - Feet 20	Slot Size - Inches .008
Screen Type Pvc slotted	Depth to Bottom - Feet 300	

GEOLOGIC DATA (Office Use Only)			
Surface Elev.	Geologic Unit	Unit Thickness	Depth to Top
Subs. SWL	Date	Analysis	Aquifer Test
Driller's Remarks well head grouted by driller. pump and slab installed by owner			

DESCRIPTION OF FORMATIONS ENCOUNTERED	FROM	TO	FORMATIONS (Continued)	FROM	TO
Red clay	0	45	RECEIVED		
Red sand w/ gravel	45	100			
Blue clay	100	260			
Blue/grey sand	260	300			
Blue clay	300	-			
			FEB 2 1990		
			Department of Natural Resources Bureau of Land & Water Resources		
IF MORE SPACE IS NEEDED, USE BACK					

If well telescopes please sketch and show depths.

GROUND LEVEL

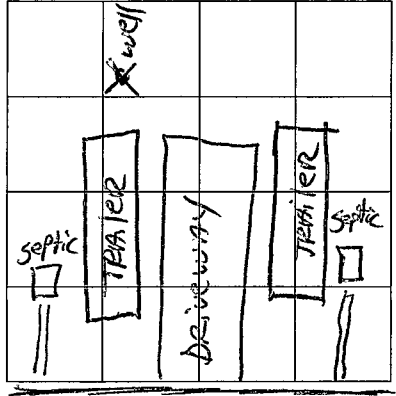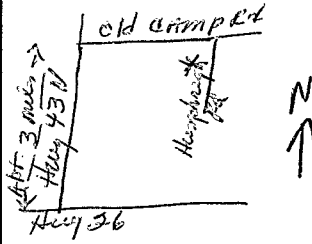

street

SECTION 14

Please indicate well location X.

ADDITIONAL INFORMATION

If more than one screen,
show location of each on sketch.