

MISSISSIPPI DEPARTMENT OF NATURAL RESOURCES

Bureau of Land and Water Resources

Southport Mall

P.O. Box 10631

Jackson, Mississippi 39209

WATER WELL DRILLERS LOG

P. RIVER  
F 2049

11-30 1990  
date well completed

90 Bed Penton  
firm name

Pearl River  
county well located

LANDOWNER: Rolf Ferguson  
R.T. & Box 190-A  
Carrier Miss.  
(mailing address)

description of formations encountered	from	to
<u>Red shale</u>	<u>0</u>	<u>18</u>
<u>Red sand</u>	<u>18</u>	<u>30</u>
<u>blue shale</u>	<u>30</u>	<u>210</u>
<u>blue sand</u>	<u>210</u>	<u>330</u>
<u>blue shale</u>	<u>330</u>	<u>390</u>
<u>gray sand</u>	<u>390</u>	<u>462</u>

WELL LOCATION:  
sec. 35 T. 3 N. R. 18 E.  
1/4 miles West of Carrier  
(distance) (direction) (nearest town)

WELL PURPOSE: home  
(home, irrigation, municipal, industrial)

WELL COMPLETION DATA:

(1) diameter (inches) 4

(2) total depth (feet) 462

(3) static water level (feet) 140 below above top of ground.

(4) casing PVC 462  
(material) (depth)  
4 1/2 If telescope see back.  
(size)


(5) screen 10 452  
(length) (depth to top)  
1 1/2 PVC  
(size) (material)

(6) pump 1 27  
(HP) (yield gpm)  
Elect  
(type power)

(7) electric log no  
(yes or no)

(organization running log)

(8) how well bottom plugged plugged

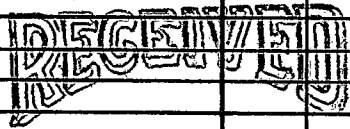

FEB 19 1991

Dept. of Environmental Quality  
Bureau of Land & Water Resources

DRILLERS REMARKS:

If well telescopes please sketch and show depths.


GROUND LEVEL

182 4''

280

2''

182-4''

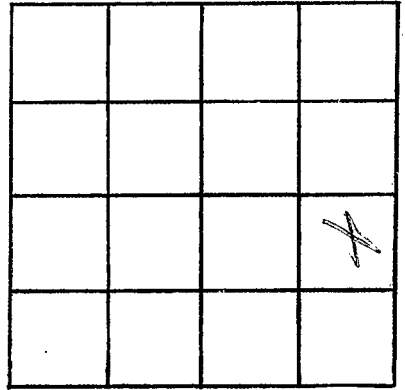

SECTION \_\_\_\_\_

Please indicate well location X.

ADDITIONAL INFORMATION

If more than one screen,  
show locations of each on sketch.