

MISSISSIPPI DEPARTMENT OF NATURAL RESOURCES

Bureau of Land and Water Resources

Southport Mall

P.O. Box 10631

Jackson, Mississippi 39209

WATER WELL DRILLERS LOG

P. Rider
J 2053

11-10-92 Bud Peaton Water Well
date well completed firm name

Pearl River
county well located


LANDOWNER: Michael Carmichael
521 Old River Rd
Henleyfield MS 39426
(mailing address)

description of formations encountered	from	to
blue clay	0	126
blue sand	126	190
blue clay	190	250
gray sand	250	315
blue clay	315	405
Gray sand	405	525

WELL LOCATION:
sec. 34 T 3 N R 18 E
(S) (W)
1 miles west of Henleyfield
(distance) (direction) (nearest town)

WELL PURPOSE: Home
(home, irrigation, municipal, industrial)

- WELL COMPLETION DATA:
- (1) diameter (inches) 4x2
 - (2) total depth (feet) 525
 - (3) static water level (feet) _____ below above top of ground.
 - (4) casing PVC, 515
(material) (depth)
4x2 if telescope see back.
(size)
 - (5) screen 10, 515
(length) (depth to top)
2, PVC
(size) (material)
 - (6) pump 1, 18
(HP) (yield gpm)
electric
(type power)
 - (7) electric log NO
(yes or no)
(organization running log)
 - (8) how well bottom plugged sandshark

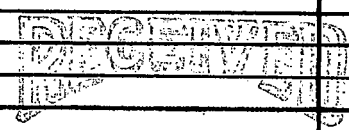

FFR 2.5 1003


Dept. of Environmental Quality
Office of Land & Water Resources

DRILLERS REMARKS:

If well telescopes please sketch and show depths.

GROUND LEVEL

195' 4"
330' 2"

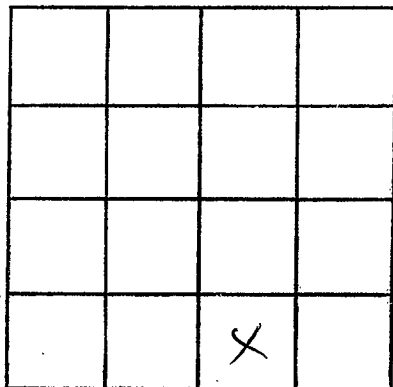

SECTION _____

Please indicate well location X.

ADDITIONAL INFORMATION

If more than one screen,
show locations of each on sketch.