

Elog # 98

MISSISSIPPI BOARD OF WATER COMMISSIONERS
416 North State Street
Jackson, Mississippi 39201

Coded

On 12-17-70

WATER WELL DRILLERS LOG

Best back 12-21-70

PEARL RIVER
K I
12-9-70

Dec. 9
date well completed

NEIL LUMPKIN WELL DRILLING SERVICE

P. O. BOX 117
CARROLL, MISS.

Pearl River

county well located

LANDOWNER: Herman Ladner
Paplarville, R.
(mailing address)

description of formations encountered	depth	
	from	to
Surface Clay	0	10
band of gravel	10	40
Blue Clay	40	90
Good sand	90	195
Blue clay	195	260
band	260	330
Clay	330	410
sand	410	510
Clay	510	570
sand	570	640
Clay	640	705
sand	705	770
Clay	770	840
sand	840	890
Clay	890	920
sand	920	945
Clay	945	995
Good sand	995	1001

WELL LOCATION:
sec. 25 T. 3 S. R. 17 E.
14 miles SW of Paplarville
(distance) (direction) (nearest town)

WELL PURPOSE: EXPERIMENT
(home, irrigation, municipal, industrial)

- WELL COMPLETION DATA:
- (1) diameter (inches) 5 in. hole
 - (2) total depth (feet) 1001
 - (3) static water level (feet) _____ below/above top of ground.
 - (4) casing Best Hole
(material) (depth)
no well
(size) if telescope see back.
 - (5) screen _____
(length) (depth to top)
(size) (material)
 - (6) pump _____
(HP) (yield gpm)
(type-power)
 - (7) electric log yes
(yes or no)
MCS
(organization running log)
 - (8) how well bottom plugged _____


DEC 16 1970

DRILLERS REMARKS:

MCS FILE OF
WATER COMM.

If well telescopes please sketch and show depths.

GROUND LEVEL

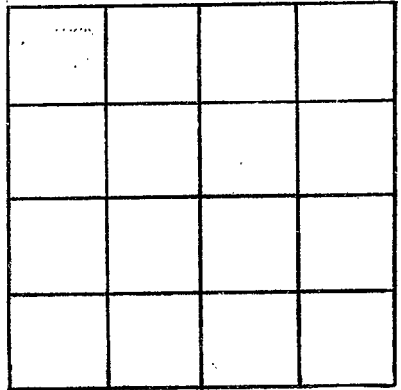

SECTION _____

Please indicate well location X.

ADDITIONAL INFORMATION

If more than one screen,
show locations of each on sketch.