

PEARL RIVER

K-2

7-16-71

MISSISSIPPI BOARD OF WATER COMMISSIONERS
416 North State Street
Jackson, Mississippi 39201

CODED

WATER WELL DRILLERS LOG

7-16

date well completed

1971 Penton Well Serv

firm name

Pearl River

county well located

LANDOWNER: Dwight Tyves

Rt. 3

Poplarville, Miss

(mailing address)

description of formations encountered

from to

Surface clay

0 16

Sand

16 40

White clay

40 90

Sand

90 216

Blue clay

216 245

Sand

245 306

WELL LOCATION:

sec. 11 T 3 S R 17 E W

6 miles East of Crossroads
(distance) (direction) (nearest town)

WELL PURPOSE: Home

(home, irrigation, municipal, industrial)

WELL COMPLETION DATA:

- (1) diameter (inches) 2
- (2) total depth (feet) 306
- (3) static water level (feet) 24 below top of ground.
- (4) casing Galv, 296 (material), (depth)
2 (size) if telescope see back.
- (5) screen 10, 296 (length), (depth to top)
2, S. Steel (size), (material)
- (6) pump 1 (HP), 12 (yield gpm)
Elec (type power)
- (7) electric log NO (yes or no)

(organization running log)

(8) how well bottom plugged B.W. Value

CODED


AUG 3 1971

MISS. BD. OF WATER COMMISSIONERS

DRILLERS REMARKS:

If well telescopes please sketch and show depths.

GROUND LEVEL

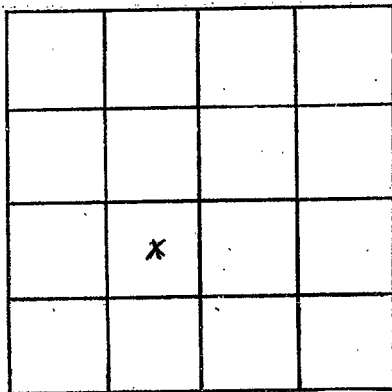

SECTION 11

Please indicate well location X.

ADDITIONAL INFORMATION

If more than one screen,
show locations of each on sketch.