

Pearl R.
 W K-3
 7-27-60

WATER WELL DRILLERS LOG

(?)

Date: 7-27, 1960, Driller: Quick + Price County P. R.
2581 (Name) From to:

(1) Owner of Land: Charlie Alexander
 (Name)
Pecayune Miss.
 (Address)

(2) Location: 1/4, 1/4, Sec. 36 T3 R17
 _____ miles _____ of _____
 (distance) (direction) (Nearest Town)

(3) Topography: _____
 (Hilly) (Flat) (Level)

(4) Purpose of Well: Domestic
 (Domestic Irrigation
 Municipal, Industrial, Other)

Description & Color of Materials Sand, Clay, Red Clay, Shell, etc.	Thick- ness Feet	Depth Feet
CODED Surface Sand?	0	60
Clay Blue	60	200
Gravel Sand	200	350
Clay	350	450
Sand	450	490
Clay Blue	490	525
Gravel Sand	525	575

Information upon completion of well:

(1) Diameter 2 inches.

(2) Total Depth 575 feet.


(3) Water Level Flow feet below top of ground.

(4) Cased to _____, Size _____

(5) Screen: Size 2", Length 20'

(6) Were any formations sealed against pollution?
 _____ yes, No no.

CODED

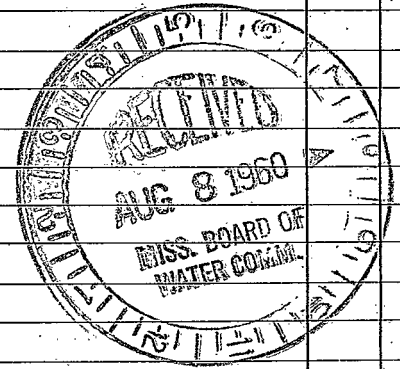

If YES depth of formation _____

Why _____

Drillers Remarks: _____

(6)

Well No.

(Use Back Side)

