

K-4

WATER WELL DRILLERS LOG

E-300

7-29-60

Date: 7-29, 1960, Driller: Quick & Grace County P. R.
1960, 2440, 2452 (Name)

(1) Owner of Land: Virgil Burge
(Name)
Poplarville, Miss.
(Address)

(2) Location: 1/4, 1/4, Sec. 8 T 3 R 17
12 miles west of Pop-
(distance) (direction) (Nearest Town)

(3) Topography: (Hilly) (Flat) (Level)

(4) Purpose of Well: Domestic
(Domestic Irrigation, Municipal, Industrial, Other)

Description & Color of Sand, Clay, Red Clay, Silts, etc.	Thickness Feet	Depth Feet
<u>Shales, Clay</u>	<u>0</u>	<u>20</u>
<u>Sand + gravel</u>	<u>20</u>	<u>370</u>
<u>Blue clay -</u>	<u>370</u>	<u>518</u>
<u>good sand -</u>	<u>518</u>	<u>552</u>

Information upon completion of well:

(1) Diameter 2 inches.

(2) Total Depth 552 feet.

(3) Water Level 59 feet below top of ground.

(4) Cased to _____, Size _____

(5) Screen: Size 2", Length 5'


(6) Were any formations sealed against pollution?
_____ yes, No no.

If YES depth of formation _____

Why _____

Drillers Remarks: Good Pump Well -

CODED

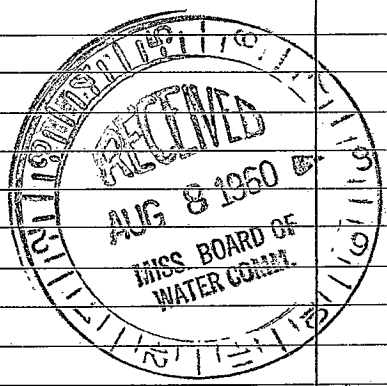

(7)

Well No.

(Use Back Side)

