

PEARL RIVER
K8
9-20-71

MISSISSIPPI
BOARD OF WATER COMMISSIONERS
416 North State Street
Jackson, Mississippi 39201

CODED

WATER WELL DRILLERS LOG

9-20 1971 McShane Water Well Service Pearl River
date well completed firm name county well located

LANDOWNER: Joe Humpers
Rt #1 Poplarville, Miss

description of formations encountered	from to	
<u>Clay</u>	<u>0</u>	<u>22</u>
<u>Fine Sand</u>	<u>22</u>	<u>40</u>
<u>Clay</u>	<u>40</u>	<u>65</u>
<u>Sand</u>	<u>65</u>	<u>100</u>

(mailing address)

WELL LOCATION:
sec. 3 T. 3 S. R. 17 E. W.
2 miles East of Crossroads
(distance) (direction) (nearest town)

WELL PURPOSE: Home
(home, irrigation, municipal, industrial)

WELL COMPLETION DATA:

- (1) diameter (inches) 4"
- (2) total depth (feet) 100'
- (3) static water level (feet) 60 below top of ground.
- (4) casing PVC, 100'
(material) (depth)
(size) if telescope see back.
- (5) screen 10', 90
(length) (depth to top)
4", PVC
(size) (material)
- (6) pump 1/2, 15
(HP) (yield gpm)
Electric
(type power)
- (7) electric log no
(yes or no)

CODED

(organization running log)

(8) how well bottom plugged Barb
Pressure Valve


NOV 15 1971

DRILLERS REMARKS:

MISSISSIPPI
BOARD OF WATER COMMISSIONERS
JACKSON, MISSISSIPPI

If well telescopes please sketch and show depths.

GROUND LEVEL

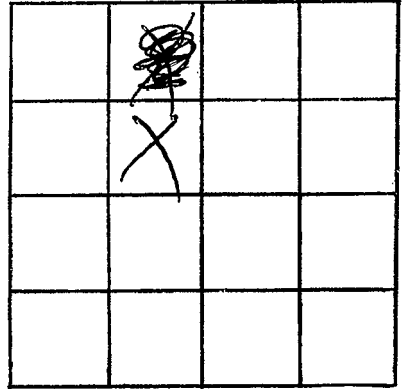

SECTION ~~18~~ 18

Please indicate well location X.

ADDITIONAL INFORMATION

If more than one screen, show locations of each on sketch.