

Pearl River
K 12
12-15-71

MISSISSIPPI
 BOARD OF WATER COMMISSIONERS
 416 North State Street
 Jackson, Mississippi 39201

FEB - 3 1971
 MISS. BD.
 WATER CO.
RECORDED

WATER WELL DRILLERS LOG

Dec-15 1971 *Hand Woodland* Pearl River
 date well completed firm name county well located

LANDOWNER: *Bethel Baptist Church*
Church Rt. 1
Poplarville, Miss.
 (mailing address)

WELL LOCATION:
 sec. 1 T. 3 R. 17
3 miles *North* of *Crossland*
 (distance) (direction) (nearest town)

WELL PURPOSE: *Church*
 (home, irrigation, municipal, industrial)


- WELL COMPLETION DATA:
- (1) diameter (inches) 2"
 - (2) total depth (feet) 230'
 - (3) static water level (feet) flung
 top of ground.
 - (4) casing plastic 230'
 (material) (depth)
 (size) if telescope see back.
 - (5) screen 12" 230'
 (length) (depth to top)
2" plaster
 (size) (material)
 - (6) pump 1/2 10
 (HP) (yield gpm)
115 AC
 (type power)
 - (7) electric log no
 (yes or no)
yes
 (organization running log)
 - (8) how well bottom plugged _____

description of formations encountered	from	to
<i>Red clay</i>	<i>0</i>	<i>17'</i>
<i>white sand</i>	<i>17'</i>	<i>35'</i>
<i>blue clay</i>	<i>35</i>	<i>190'</i>
<i>blue sand</i>	<i>190</i>	<i>200</i>
<i>blue sand chert & clay liny rock</i>	<i>200</i>	<i>230</i>

DRILLERS REMARKS:

If well telescopes please sketch and show depths.

GROUND LEVEL

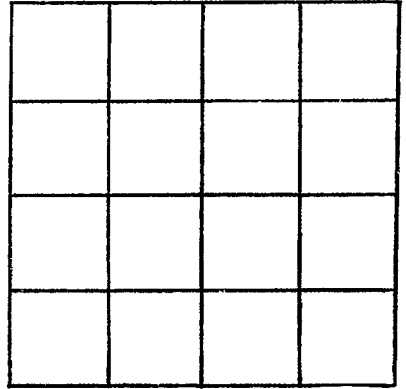

SECTION _____

Please indicate well location X.

ADDITIONAL INFORMATION

If more than one screen, show locations of each on sketch.