

MISSISSIPPI
BOARD OF WATER COMMISSIONERS
416 North State Street
Jackson, Mississippi 39201

CODED

WATER WELL DRILLERS LOG

PEARL RIVER
K 14
6-22-72

6-22 date well completed 1972 Bud Pentecost firm name Pearl River county well located

LANDOWNER:
Bugs Clark
Poplarville, Miss.
(mailing address)

description of formations encountered		from	to
red shale		0	24
red sand & rock		24	105

WELL LOCATION:
603 sec 3 T 17 R 17 S E
18 miles W of Poplarville
(distance) (direction) (nearest town)

WELL PURPOSE: Home
(home, irrigation, municipal, industrial)

- WELL COMPLETION DATA:
- diameter (inches) 4 1/2
 - total depth (feet) 105
 - static water level (feet) 42 below top of ground.
 - casing PVC 95
(material) (depth)
 - screen 10 95
(length) (depth to top)
 - pump 1/2 850
(HP) (yield gpm)
 - electric electric
(type power)
 - electric log NO
(yes or no)

CODED


(organization running log)
(8) how well bottom plugged hard shut

JUL 10 1972

DRILLERS REMARKS:

If well telescopes please sketch and show depths.

GROUND LEVEL

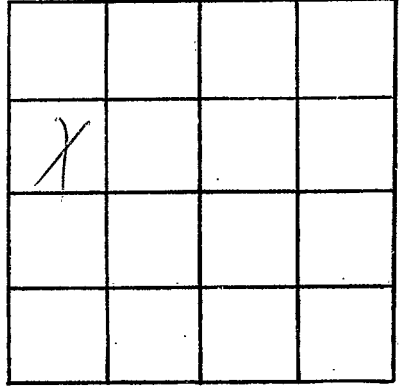

SECTION _____

Please indicate well location X.

ADDITIONAL INFORMATION

If more than one screen,
show locations of each on sketch.