

PEARL RIVER
K 15
6-23-72

MISSISSIPPI
BOARD OF WATER COMMISSIONERS
416 North State Street
Jackson, Mississippi 39201

WATER WELL DRILLERS LOG

CODED

6-23-72 date well completed
Burd Pentecost firm name
Pearl River county well located

LANDOWNER:
Nausey Barber
Poplarville, Miss
(mailing address)

description of formations encountered
red shale
sand & rock
from 9' to 8' 75'

WELL LOCATION:
sec 6 T 3 N R 17 E
18 miles W of Poplarville
(distance) (direction) (nearest town)

WELL PURPOSE: Home
(home, irrigation, municipal, industrial)

WELL COMPLETION DATA:

- (1) diameter (inches) 2 in
- (2) total depth (feet) 45
- (3) static water level (feet) 6 below top of ground
- (4) casing PVC 40 (material) (depth)
- (size) if telescope see back.
- (5) screen 5 40 (length) (depth to top)
- 2 x 5 (size) PVC (material)
- (6) pump (HP) (yield gpm)
electric (type power)
- (7) electric log NO (yes or no)

CODED

(organization running log)


(8) how well bottom plugged
Sand & Shale

DRILLERS REMARKS:
No pump furnished

JUL 10 1972

If well telescopes please sketch and show depths.

GROUND LEVEL

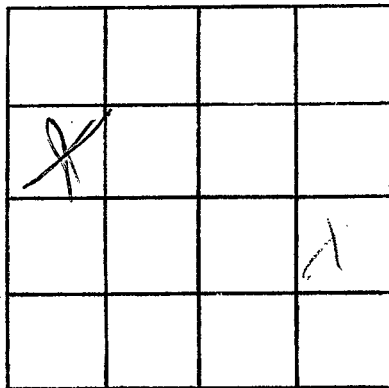

SECTION _____

Please indicate well location X.

ADDITIONAL INFORMATION

If more than one screen,
show locations of each on sketch.