

PEARL RIVER
K 16
5-8-72

MISSISSIPPI
 BOARD OF WATER COMMISSIONERS
 416 North State Street
 Jackson, Mississippi 39201

CODED

WATER WELL DRILLERS LOG

5-8 1972
 date well completed

Bud Ponton
 firm name

Pearl River
 county well located

LANDOWNER:

Anthony Peters
 Poplarville, Miss
 (mailing address)

description of formations encountered

red shale
 sand & rock
 from 0 to 18
 to 18 64

WELL LOCATION:

sec. 23 N 17 E
 S W
 10 miles W of Poplarville
 (distance) (direction) (nearest town)

WELL PURPOSE:

Residential
 (home, irrigation, municipal, industrial)

WELL COMPLETION DATA:

- (1) diameter (inches) 2 in
- (2) total depth (feet) 64
- (3) static water level (feet) 14 below top of ground
- (4) casing PVC 59
 (material) (depth)
 (size) if telescope see back.
- (5) screen 54 59
 (length) (depth to top)
2x5 PVC
 (size) (material)
- (6) pump 1 750
 (HP) (yield gpm)
electric
 (type power)
- (7) electric log NO
 (yes or no)

(organization running log)

(8) how well bottom plugged
Sand Shale


CODED

FORM 10 1970

DRILLERS REMARKS:

If well telescopes please sketch and show depths.

GROUND LEVEL

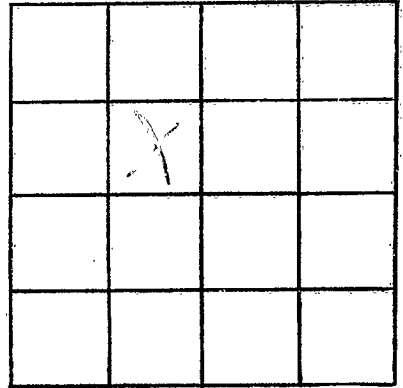

SECTION _____

Please indicate well location X.

ADDITIONAL INFORMATION

If more than one screen, show locations of each on sketch.