

PEARL RIVER
K 17
9-16-72

MISSISSIPPI
 BOARD OF WATER COMMISSIONERS
 416 North State Street
 Jackson, Mississippi 39201

CODED

WATER WELL DRILLERS LOG

9-16 1972 Horse A Poole Pearl River
 date well completed firm name county well located

LANDOWNER: J. D. Jones
 (mailing address)

description of formations encountered	from	to
<u>Sandy clay</u>	<u>0</u>	<u>12</u>
<u>Clay</u>	<u>12</u>	<u>36</u>
<u>Sandy clay</u>	<u>36</u>	<u>80</u>
<u>SAND</u>	<u>80</u>	<u>105</u>

WELL LOCATION:
 sec. 3 T. 3 S. R. 17 W.
10 miles SW of Poplarville
 (distance) (direction) (nearest town)

WELL PURPOSE: Home
 (home, irrigation, municipal, industrial)

- WELL COMPLETION DATA:
- diameter (inches) 4 1/2
 - total depth (feet) 105
 - static water level (feet) 50 below top of ground.
 - casing Pvc 100'
 (material) (depth)
2" if telescope see back.
 (size)
 - screen 5' 100'
 (length) (depth to top)
2" or Pvc
 (size) (material)
 - pump 1 4
 (HP) (yield gpm)
Elec
 (type power)
 - electric log No
 (yes or no)
- (organization running log)
- (8) how well bottom plugged Ball Valve

CODED


SEP 25 1972

MISSISSIPPI
 BOARD OF WATER COMMISSIONERS

DRILLERS REMARKS:

If well telescopes please sketch and show depths.

GROUND LEVEL

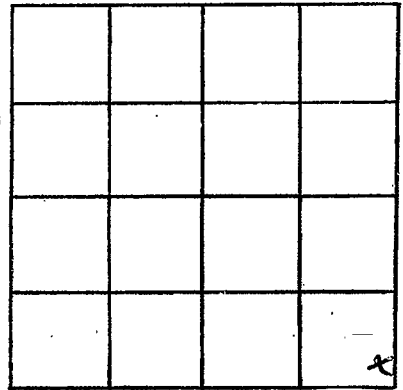

SECTION 2

Please indicate well location X.

ADDITIONAL INFORMATION

If more than one screen, show locations of each on sketch.