

Pearl River
 K 20
 6-25-69

MISSISSIPPI
 BOARD OF WATER COMMISSIONERS
 416 North State Street
 Jackson, Mississippi 39201

CODED

WATER WELL DRILLERS LOG

June 25 1969 Caskey Stafford Pearl River
 date well completed film name W county well located

LANDOWNER:

L. L. Davis

description of formations encountered

from

to

RT 1, Poplarville, Miss
 (mailing address)

Mixed Chalk 0' 50'
 Sand & Gravel 50' 79'

WELL LOCATION:

sec ~~7~~ T 3 N R 12 E
 S W
 1 1/2 miles E of Poplarville
 (distance) (direction) (nearest town)

WELL PURPOSE:

home
 (home, irrigation, municipal, industrial)

WELL COMPLETION DATA:

- (1) diameter (inches) 4"
- (2) total depth (feet) 79 ft
- (3) static water level (feet) _____ below above top of ground.
- (4) casing plastic, 69 ft
 (material) (depth)
 (size) if telescope see back.
- (5) screen 10 ft, 69 ft
 (length) (depth to top)
4" Plastic
 (size) (material)
- (6) pump 1/2 900 gal
 (HP) (yield gpm)
- ELF
 (type power)
- (7) electric log N/D
 (yes or no)

(organization running log)

(8) how well bottom plugged BWV


DRILLERS REMARKS:

NOV 7 1969

MISS. B.D. OF
 WATER

If well telescopes please sketch and show depths.

GROUND LEVEL

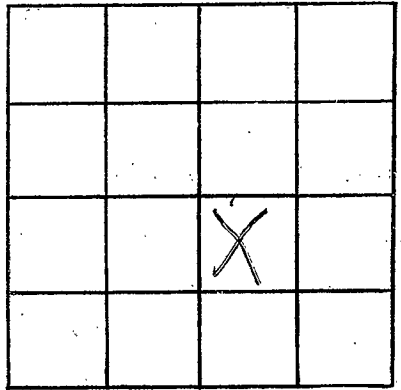

SECTION _____

Please indicate well location X.

ADDITIONAL INFORMATION

If more than one screen,
show locations of each on sketch.