

Pearl River
K 21
6 to 9

MISSISSIPPI
BOARD OF WATER COMMISSIONERS CODED
416 North State Street
Jackson, Mississippi 39201

WATER WELL DRILLERS LOG

6-30 1959 HORACE A. POOLE PEARL RIVER
date well completed firm name county well located

LANDOWNER:	description of formations encountered	from	to
JV Bagan RT# 3			
POPLARVILLE MISS (mailing address)	SAND	10	20
	CLAY	20	100
	SILT	100	105
	CLAY	105	145
	SAND	145	165

WELL LOCATION:

sec 25 T 3 R 17
7 1/2 miles S of Poplarville
(distance) (direction) (nearest town)

WELL PURPOSE:

(home, irrigation, municipal, industrial)

WELL COMPLETION DATA:

- (1) diameter (inches) 4
- (2) total depth (feet) 165
- (3) static water level (feet) 2 below top of ground.
- (4) casing PVC 160 (material) (depth)
2 (size) if telescope see back.
- (5) screen 5 160 (length) (depth to top)
- 2-010 PVC (size) (material)
- (6) pump (HP) (yield gpm)
(type power)
- (7) electric log 20 (yes or no)
(organization running log)

(8) how well bottom plugged
CRATER MAR N.S. BUN


DRILLERS REMARKS:

APR 14 1959

MISS. BD. OF WATER COM.

If well telescopes please sketch and show depths.

GROUND LEVEL

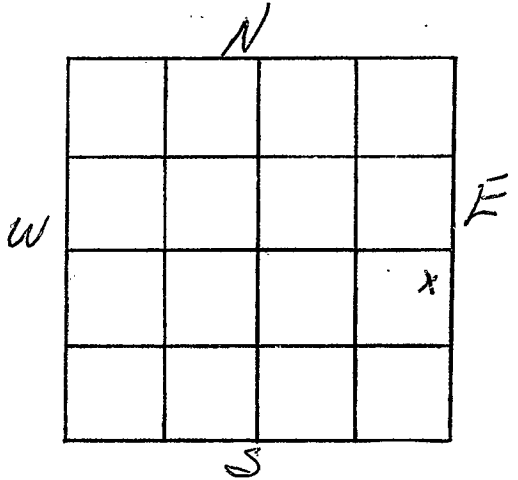

SECTION 25

Please indicate well location X.

ADDITIONAL INFORMATION

*Well flowing -
70 P.M.*

If more than one screen,
show locations of each on sketch.