

K²²
6-22-64

WATER WELL DRILLERS LOG

Date: 6-22, 19 64, Driller: Sutton Well Works County Pearl River
(Name)

(1) Owner of Land: Escambia Elec. Co
(Name)
for American T&T - Poplarville
(Address)

(2) Location: NE 1/4, SW 1/4, Sec. 7 T35R14
2 miles E, of Crossroads
(distance) (direction) (Nearest Town)

(3) Topography: hilly
(Hilly) (Flat) (Level)

(4) Purpose of Well: Industrial
(Domestic Irrigation
Municipal, Industrial, Other)

Description & Color of Materials Sand, Clay, Red Clay, Shell, etc.	Thick- ness Feet	Depth Feet
<u>surface clay</u>	<u>18</u>	<u>18</u>
<u>red sand</u>	<u>19</u>	<u>37</u>
<u>clay</u>	<u>81</u>	<u>118</u>
<u>fine Red Sand</u>	<u>42</u>	<u>160</u>
<u>blue clay</u>	<u>24</u>	<u>184</u>
<u>gray sand</u>	<u>29</u> 33	<u>213</u>

Information upon completion of well:

(1) Diameter 6 inches.

(2) Total Depth 217 feet.

(3) Water Level 8.7 feet below top of ground.

(4) Cased to all, Size 6"


(5) Screen: Size 6", Length 20'

(6) Were any formations sealed against pollution?
 yes, no.

If YES depth of formation surface

Why _____

Drillers Remarks: _____

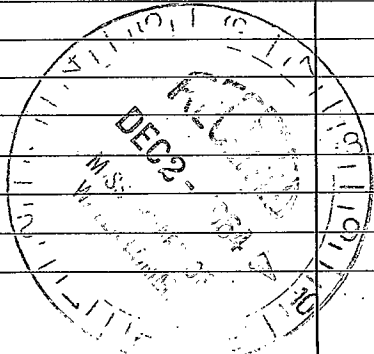

(Use Back Side)

Well No.

