

CODED

PEARL RIVER
K 23
7-15-69

MISSISSIPPI
BOARD OF WATER COMMISSIONERS
416 North State Street
Jackson, Mississippi 39201

WATER WELL DRILLERS LOG

NEIL LUMPKIN WELL DRILLING SERVICE
P. O. BOX 117
CARROLLTON, MISS.

Pearl River
county well located

7/15
date well completed

LANDOWNER: *Milton Ray Lee*
Paplarville, Miss.
Route - Whitesand
(mailing address)

description of formations encountered	depth	
	from	to
<i>Surface Clay</i>	<i>0</i>	<i>10</i>
<i>Surface Sand (Fines to better)</i>	<i>10</i>	<i>104</i>

WELL LOCATION:
sec. *14* T. *3* S. R. *17* W.
10 miles *WEST* of *Paplarville*
(distance) (direction) (nearest town)

WELL PURPOSE: *Home*
(home, irrigation, municipal, industrial)

- WELL COMPLETION DATA:
- (1) diameter (inches) *2*
 - (2) total depth (feet) *104*
 - (3) static water level (feet) *20'* below above top of ground.
 - (4) casing *galv. 99*
(material) (depth)
2"
(size) if telescope see back.
 - (5) screen *5'* *2'*
(length) (depth to top)
2" *plastic*
(size) (material)
 - (6) pump *1/2* *400 gph*
(HP) (yield gpm)
electric
(type power)
 - (7) electric log *No.*
(yes or no)

(organization running log)

(8) how well bottom plugged *Johnson*
AP Valve


DRILLERS REMARKS:

MISS. BD. OF
WATER COMMISSIONERS

1969

If well telescopes please sketch and show depths.

GROUND LEVEL

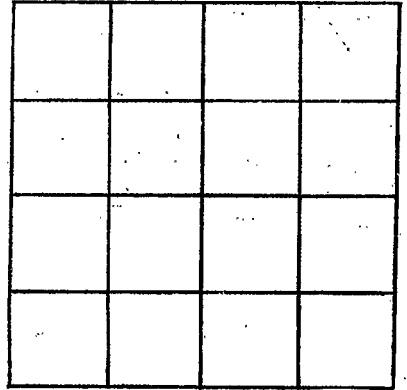

SECTION _____

Please indicate well location X.

ADDITIONAL INFORMATION

If more than one screen,
show locations of each on sketch.