

PEARL RIVER
K 24
B-5-69

MISSISSIPPI
BOARD OF WATER COMMISSIONERS
416 North State Street
Jackson, Mississippi 39201

CODED

WATER WELL DRILLERS LOG

NEIL LUMPKIN WELL DRILLING SERVICE
P. O. BOX 117

Pearl River
county well located

8-5 1969
date well completed

PEARL RIVER, MISS.
town name

LANDOWNER: *Wayne Mitchell*

description of formations encountered

from to

Poplarville Miss. Rt.
(mailing address)

<i>Surface Clay</i>	0	18
<i>Fine Sand, to top of gravel</i>	18	105

WELL LOCATION:

sec. 14 T. 3 S. R. 17 E.
10 miles WEST of Poplarville
(distance) (direction) (nearest town)

WELL PURPOSE: *home*
(home, irrigation, municipal, industrial)

WELL COMPLETION DATA:

- (1) diameter (inches) 2"
- (2) total depth (feet) 105
- (3) static water level (feet) 20 below above top of ground.
- (4) casing plastic 100'
(material) (depth)
2"
(size) if telescope see back.
- (5) screen 5'
(length) (depth to top)
2" plastic
(size) (material)
- (6) pump 1/2 600 g.p.m.
(HP) (yield/gpm)
electric
(type power)
- (7) electric log No
(yes or no)

(organization running log)

(8) how well bottom plugged Johnson
B.P. Valve


NOV 10 1969

DRILLERS REMARKS:

MISS. BD. OF
WATER COM.

If well telescopes please sketch and show depths.

GROUND LEVEL

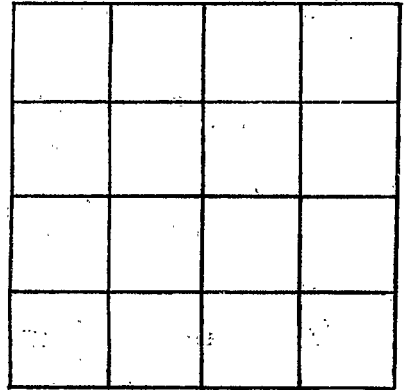

SECTION _____

Please indicate well location X.

ADDITIONAL INFORMATION

If more than one screen, show locations of each on sketch.