

**PEARL RIVER**  
 K25  
 8-12-69

MISSISSIPPI  
 BOARD OF WATER COMMISSIONERS  
 416 North State Street  
 Jackson, Mississippi 39201

CODED

WATER WELL DRILLERS LOG

8-12 1969 date well completed  
 NEIL LUMPKIN WELL DRILLING SERVICE Pearl River P.O. BOX 117  
 CLAYTON, MISS. county well located

LANDOWNER: Clint McNeill  
707 Homestead Ave  
Mitairie, La.  
 (mailing address) 70005

description of formations encountered	from	to
Surface Clay	0	18
" sand (no good)	18	35
Blue clay	35	140
Good sand	140	174

WELL LOCATION:  
 sec. 28 T. 7 S. R. 17 E.  
5 miles NW of Millard  
 (distance) (direction) (nearest town)

WELL PURPOSE: home  
 (home, irrigation, municipal, industrial)

WELL COMPLETION DATA:

(1) diameter (inches) 2"

(2) total depth (feet) 174

(3) static water level (feet) 3 below above top of ground.

(4) casing galv., 169,  
 (material) (depth)  
2"  
 (size) if telescope see back.

(5) screen 5',  
 (length) (depth to top)  
2", St. Steel  
 (size) (material)

(6) pump 3/4 600 per hr.,  
 (HP) (yield gpm)  
electric  
 (type power)

(7) electric log No,  
 (yes or no)

(organization running log)

(8) how well bottom plugged Johnson  
back pressure valve


DRILLERS REMARKS:

NOV 10 1969

MISS. Bd. of  
 WATER COMMISSIONERS

If well telescopes please sketch and show depths.

GROUND LEVEL

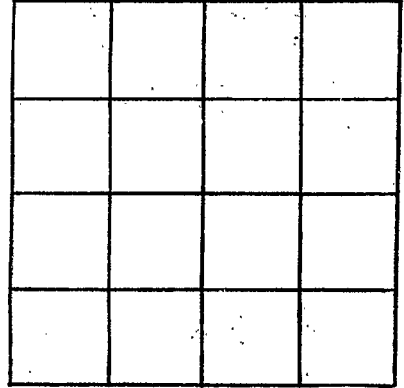

SECTION \_\_\_\_\_

Please indicate well location X.

ADDITIONAL INFORMATION

If more than one screen,  
show locations of each on sketch.