

PEARL RIVER
 K 26
 9-27-69

MISSISSIPPI
 BOARD OF WATER COMMISSIONERS
 416 North State Street
 Jackson, Mississippi 39201

CODED

WATER WELL DRILLERS LOG

NEIL LUMPKIN WELL DRILLING SERVICE Pearl River
 P. O. BOX 117
 WABERE, MISS. county well located

7-27 19 69
 date well completed

LANDOWNER: Wilmer
Whittingham
Highway 11
Picayune, Miss.
 (mailing address)

description of formations encountered	from	to
	Surface Clay	0
" "	20	40

WELL LOCATION:
 sec. 24 T 3 R 17
12 miles SW of Shallice
 (distance) (direction) (nearest town)

blue clay	40	60
good sand	60	111

WELL PURPOSE: farm
 (home, irrigation, municipal, industrial)

WELL COMPLETION DATA:

(1) diameter (inches) 8

(2) total depth (feet) 111

(3) static water level (feet) 30 below above top of ground.

(4) casing lpc, (material) (depth)
2" if telescope see back. (size)

(5) screen 5' (length) (depth to top)
2" (size) st steel (material)

(6) pump 1/2 (HP) 400gph (yield gpm)
electric (type power)

(7) electric log No (yes or no)
 (organization running log)


(8) how well bottom plugged Johnson
6 P Valve

DRILLERS REMARKS:

NOV 10 1969
 MISS. DEPT. OF WATER CONTROL

If well telescopes please sketch and show depths.

GROUND LEVEL

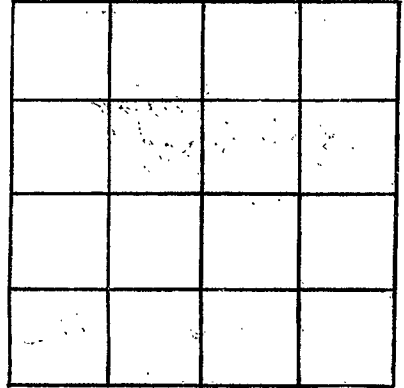

SECTION _____

Please indicate well location X.

ADDITIONAL INFORMATION

If more than one screen, show locations of each on sketch.