

PEARL RIVER

K 27

10-11-69

MISSISSIPPI  
 BOARD OF WATER COMMISSIONERS  
 416 North State Street  
 Jackson, Mississippi 39201

CODED

WATER WELL DRILLERS LOG

10-11-69  
date well completed

NEIL LUMPKIN WELL DRILLING SERVICE  
P. O. BOX 117

CARRIAGE, MISS.

PEARL RIVER  
county well located

LANDOWNER: Pearl River  
Plantation  
James F. Jacks

Poplarville, Route 1  
(mailing address)

description of formations  
encountered

from to

surface clay 0 30

n sand (no good) 30 320

Blue clay 320 450

good sand 450 515

WELL LOCATION:

sec. 15 T 3 S R 17 E  
10 miles west of Poplarville  
(distance) (direction) (nearest town)

WELL PURPOSE: Farm  
(home, irrigation, municipal, industrial)

WELL COMPLETION DATA:

(1) diameter (inches) 2"  
(2) total depth (feet) 515  
(3) static water level (feet) 52 below  
top of ground.

(4) casing galv. (material), (depth)  
2" (size) if telescope see back.

(5) screen 10' (length) (depth to top)

2" St. Steel (size) (material)  
(6) pump 1 600 gpm (HP) (yield gpm)

electric (type power)

(7) electric log No (yes or no)

(organization running log)


(8) how well bottom plugged Johnson  
A P Valve

DRILLERS REMARKS:

NOV 10 1969  
MISS. Bd. of  
WATER

If well telescopes please sketch and show depths.

GROUND LEVEL

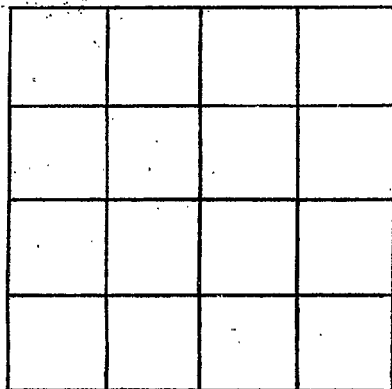

SECTION \_\_\_\_\_

Please indicate well location X.

ADDITIONAL INFORMATION

If more than one screen, show locations of each on sketch.