

PEARL RIVER
 K 28
 10-16-69

MISSISSIPPI
 BOARD OF WATER COMMISSIONERS
 416 North State Street
 Jackson, Mississippi 39201

CODED

WATER WELL DRILLERS LOG

10-16 1969 Penion well serv Pearl River
 date well completed firm name county well located

LANDOWNER: Richard Terrill
Rt. 3 No Box
Poplarville Miss
 (mailing address)

description of formations encountered	from	to
	Surface Clay	0
Red sand	26	42
Blue clay	42	146
Grey sand	146	173

WELL LOCATION:
 sec. 25 T 3 R 17
 (distance) miles (direction) of (nearest town)

WELL PURPOSE: Home
 (home, irrigation, municipal, industrial)

- WELL COMPLETION DATA:
- (1) diameter (inches) 2
 - (2) total depth (feet) 173
 - (3) static water level (feet) 4 ~~feet~~ above top of ground.
 - (4) casing Galv, 168
 (material) (depth)
2" If telescope see back.
 (size)
 - (5) screen 5, 168
 (length) (depth to top)
2", St. steel
 (size) (material)
 - (6) pump no
 (HP) (yield gpm)
 (type power)
 - (7) electric log NO
 (yes or no)
 (organization running log)
 - (8) how well bottom plugged B.W. Valve


NOV 13 1969

DRILLERS REMARKS:

MISS. BD. OF
 WATER COMM.

If well telescopes please sketch and show depths.

GROUND LEVEL

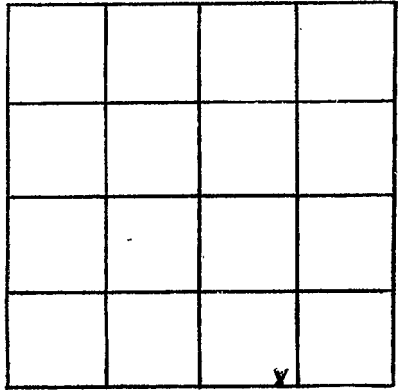

SECTION 25

Please indicate well location X.

ADDITIONAL INFORMATION

If more than one screen,
show locations of each on sketch.