

PEARL RIVER  
K 29  
10-23-69

MISSISSIPPI  
BOARD OF WATER COMMISSIONERS  
416 North State Street  
Jackson, Mississippi 39201

CODED

WATER WELL DRILLERS LOG SERVICE

NEIL LUMPKIN WELL DRILLING SERVICE  
P. O. BOX 117  
CARRIERE, MISS.  
firm name

Charles River  
county well located

10-23, 1969  
date well completed

LANDOWNER: Jerry Alexander  
Poppasville Route  
(mailing address)

description of formations encountered	from	to
surface clay	0	15
" sand (no good)	15	18
solid blue clay	18	110
good sand	110	160

WELL LOCATION:  
sec. 36 T 3 R 17  
14 miles SW of Poplarville  
(distance) (direction) (nearest town)

WELL PURPOSE: home  
(home, irrigation, municipal, industrial)


- WELL COMPLETION DATA:
- (1) diameter (inches) 2"
  - (2) total depth (feet) 160
  - (3) static water level (feet) 12 below top of ground.
  - (4) casing galv. (material), (depth) 2" if telescope see back. (size)
  - (5) screen 5' (length), (depth to top) 2" St. St. (size), (material)
  - (6) pump 1/2 (HP), 600 gpm (yield gpm), electric (type power)
  - (7) electric log no. (yes or no)
  - (organization running log)
  - (8) how well bottom plugged Johnson AP Valve

DRILLERS REMARKS:

MISS. BD. OF WATER COMMISSIONERS

If well telescopes please sketch and show depths.

GROUND LEVEL

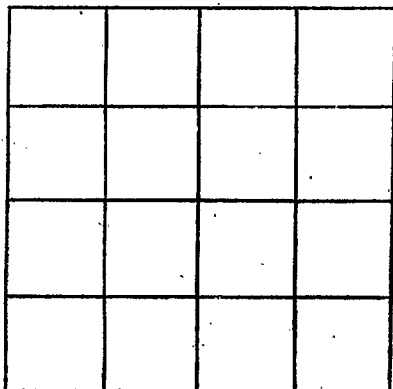

SECTION \_\_\_\_\_

Please indicate well location X.

ADDITIONAL INFORMATION

If more than one screen,  
show locations of each on sketch.