

CODED

MISSISSIPPI
BOARD OF WATER COMMISSIONERS
416 North State Street
Jackson, Mississippi 39201

WATER WELL DRILLERS LOG

PEARL RIVER

K 30

2-10-70

2-10-70

date well completed

20 Enslay Stafford Water Well Service
firm name

Pearl River
county well located

LANDOWNER: John Amacker

description of formations encountered

from

to

Route 3

Top Soil

0

5 ft

Poplarville, Miss.
(mailing address)

Clay

5

10 ft

WELL LOCATION:

sec. 14 T 3 N R 12 E
S W
1 1/2 miles S of Poplarville
(distance) (direction) (nearest town)

Sand & Pea Gravel

10 ft

50 ft

WELL PURPOSE:

(home, irrigation, municipal, industrial)

WELL COMPLETION DATA:

- (1) diameter (inches) 4 in
- (2) total depth (feet) 50 ft
- (3) static water level (feet) 20 below top of ground
- (4) casing (material) Plastic, (depth) 50 ft
4 in If telescope see back. (size)
- (5) screen 10 ft, 40 ft (length) (depth to top)
4 in, Plastic (size) (material)
- (6) pump (HP) (yield gpm)
(type power)
- (7) electric log (yes or no)
(organization running log)
- (8) how well bottom plugged B.W.V.

FEB 16 1970


DRILLERS REMARKS:

Charles Stafford

MISS. BD. OF
WATER COM.

If well telescopes please sketch and show depths.

GROUND LEVEL

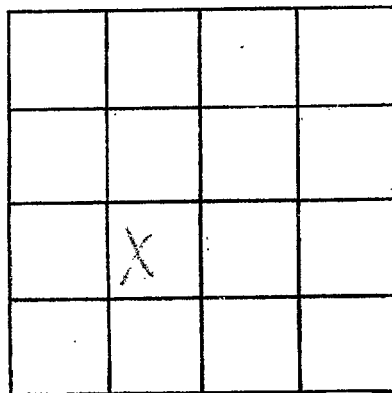

SECTION _____

Please indicate well location X.

ADDITIONAL INFORMATION

If more than one screen,
show locations of each on sketch.