

Pearl River  
K 32  
7-17-70

MISSISSIPPI  
BOARD OF WATER COMMISSIONERS  
416 North State Street  
Jackson, Mississippi 39201

**CODED**

WATER WELL DRILLERS LOG

7-17 1970 Mc Selva's Water Well Service Pearl River  
date well completed firm name county well located

LANDOWNER: James D. Ambrose  
Rt #1 Poplarville, Miss.  
(mailing address)

description of formations encountered	depth	
	from	to
<u>Clay</u>	<u>0</u>	<u>10</u>
<u>Loess &amp; Pea Shand</u>	<u>10</u>	<u>42</u>

WELL LOCATION:  
sec. 14-3 T. 3 S. R. 17 E.  
1/2 miles N of Cross Roads  
(distance) (direction) (nearest town)

WELL PURPOSE: Atom  
(home, irrigation, municipal, industrial)

WELL COMPLETION DATA:

(1) diameter (inches) 4"

(2) total depth (feet) 42

(3) static water level (feet) 8' below above top of ground.

(4) casing PVC 42  
(material) (depth)  
(size) If telescope see back.

(5) screen 5' 37'  
(length) (depth to top)  
4" PVC  
(size) (material)

(6) pump 1/3 9  
(HP) (yield gpm)  
Electric  
(type power)

(7) electric log NO  
(yes or no)  
(organization running log)

(8) how well bottom plugged Block  
Pressure Valve

**CODED**


JUL 20 1970

MISS. BD. OF  
WATER COMMISSIONERS

DRILLERS REMARKS:

If well telescopes please sketch and show depths.

GROUND LEVEL

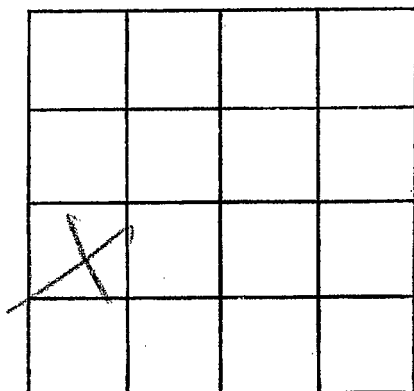

SECTION 3

Please indicate well location X.

ADDITIONAL INFORMATION

If more than one screen,  
show locations of each on sketch.