

PEARL RIVER

K33

8-15-70

MISSISSIPPI  
 BOARD OF WATER COMMISSIONERS  
 416 North State Street  
 Jackson, Mississippi 39201

CODED

WATER WELL DRILLERS LOG

8-15-70

1970 Harold Woodward

Pearl River

date well completed

firm name

county well located

August 15/1970

LANDOWNER:

Robert

description of formations encountered

from

to

Amacher

Red Clay

0 15'

Rt. 1 Poplarville  
(mailing address)

White Clay

15 50

WELL LOCATION:

sec. 9 T. 3 R. 12

fine sand

52 60

2 1/2 miles N W of Whitehall  
(distance) (direction) (nearest town)

med. sand (700 rocks) 61-75

WELL PURPOSE:

irrigation  
(home, irrigation, municipal, industrial)

Chorse White sand  
3 Am rocks

89 95

WELL COMPLETION DATA:

(1) diameter (inches)

4"

Very Chorse sand  
3 large rock

95 116'

(2) total depth (feet)

157 ft.

(3) static water level (feet) 75 below top of ground.

Very large sand

(4) casing

plastic  
(material)

(depth)

3 gravel

116 157

If telescope see back.  
(size)

(5) screen

30' 1  
(length) (depth to top)

(size)

(material)

(6) pump

2  
(HP)

20  
(yield gal/min)

CODED

(7) electric log

no  
(yes or no)

set at

127 ft.

(organization running log)

(8) how well bottom plugged


2" SS  
P.W. Kauls

AUG 25 1970

DRILLERS REMARKS:

If well telescopes please sketch and show depths.

GROUND LEVEL

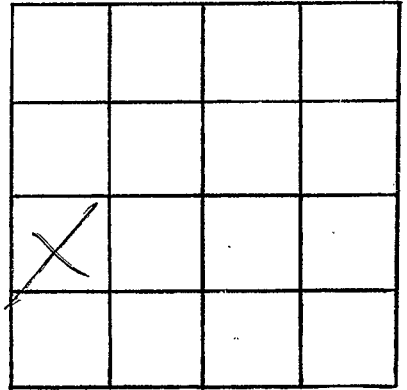

SECTION 9

Please indicate well location X.

ADDITIONAL INFORMATION

If more than one screen,  
show locations of each on sketch.