

PEARL RIVER  
K34  
8-18-70

MISSISSIPPI  
BOARD OF WATER COMMISSIONERS  
416 North State Street  
Jackson, Mississippi 39201

CODED

WATER WELL DRILLERS LOG

Drilling Pearl River

August 18 1970 Harold Woodard firm name  
date well completed 06 Bogalusa, La county well located

LANDOWNER: Dentson  
Wheat  
St. 3 Bogalusa, Miss.  
(mailing address)  
WELL LOCATION:  
sec. 10 T 3 S R 11 W  
miles of (distance) (direction) of (nearest town)

description of formations encountered	from	to
sand	0	15
white clay	15	27
fine sand	27	38
dry sand pits		
Chonse	38	50
sand & gravel	50	60'
Very good sand		
gravel	60	78'

WELL PURPOSE:  
(home, irrigation, municipal, industrial)

WELL COMPLETION DATA:

- (1) diameter (inches) 2"
- (2) total depth (feet) 78
- (3) static water level (feet) 22 below top of ground.
- (4) casing 73' (material) (depth)  
(size) If telescope see back.
- (5) screen 5' 73 (length) (depth to top)  
2" (size) (material)
- (6) pump 1/2 10 (HP) (yield gpm)  
11.5 AC (type power)
- (7) electric log 720 (yes or no)  
(organization running log)
- (8) how well bottom plugged 2" 55  
13 is hard

CODED

set at 78'


AUG 25 1970

DRILLERS REMARKS:

MISS. BD. OF  
WATER

If well telescopes please sketch and show depths.

GROUND LEVEL

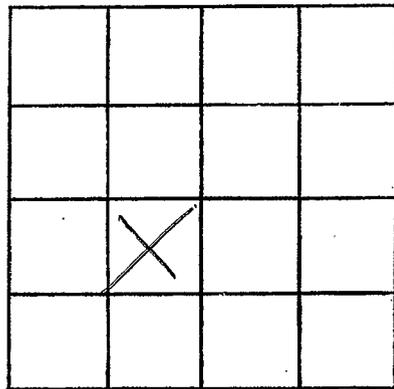

SECTION 10

Please indicate well location X.

ADDITIONAL INFORMATION

If more than one screen, show locations of each on sketch.