

PEARL RIVER

K 35

8-27-70

MISSISSIPPI
BOARD OF WATER COMMISSIONERS
416 North State Street
Jackson, Mississippi 39201

CODED

WATER WELL DRILLERS LOG

NEIL LUMPKIN WELL DRILLING SERVICE
P. O. BOX 117

CARRISBERG, MISS.

Pearl River

8-27 1970

date well completed

county well located

LANDOWNER: *Pearl River*

description of formations encountered

from

to

Plantation, Inc.

Surface clay

0

20

*P.O. Box 437
Tuplarville, Miss. RT 3*
(mailing address)

v sand

20

80

WELL LOCATION:

sec. ~~29~~ *3* T. ~~3~~ S. R. ~~17~~ *17* W.

Blue clay

80

190

8 miles *NW* of *McNeill*
(distance) (direction) (nearest town)

Good sand

190

237

WELL PURPOSE: *watering cattle*
(home, irrigation, municipal, industrial)

WELL COMPLETION DATA:

- (1) diameter (inches) 2"
- (2) total depth (feet) 237
- (3) static water level (feet) 84 below above top of ground.

(4) casing *galv.* 231
(material) (depth)

2"
(size) If telescope see back.

(5) screen 5
(length) (depth to top)

2" *St. Steel*
(size) (material)

(6) pump *Ad 3 1/2* 200 gpm
(HP) (yield gpm)

Gasoline
(type power)

(7) electric log no
(yes or no)

(organization running log)

(8) how well bottom plugged *Johnson*
Back pressure valve

DRILLERS REMARKS:


CODED

NOV 3 - 1970

MISS. BD. OF
WATER COM.

If well telescopes please sketch and show depths.

GROUND LEVEL

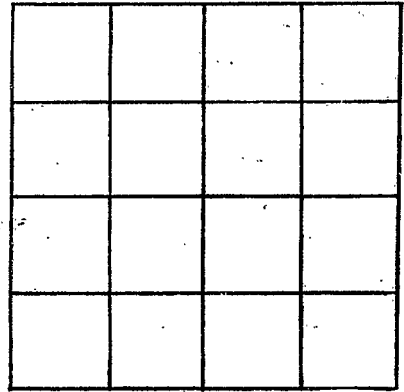

SECTION _____

Please indicate well location X.

ADDITIONAL INFORMATION

If more than one screen,
show locations of each on sketch.