

PEARL RIVER

K 37

11-19-70

MISSISSIPPI BOARD OF WATER COMMISSIONERS
416 North State Street
Jackson, Mississippi 39201

CODED

WATER WELL DRILLERS LOG

NEIL LUMPKIN WELL DRILLING SERVICE

P. O. BOX 117

CARRIAGE, MISS

Pearl River

11-19-1970
date well completed

firm name

county well located

LANDOWNER: *Kendall,
Helicopter Services,
Poplarville, Miss. Inc.
Route 3, Box 234*
(mailing address)

description of formations encountered

from to

<i>Surface clay</i>	<i>0</i>	<i>15</i>
<i>" sand,</i>	<i>15</i>	<i>60</i>
<i>no good</i>		
<i>Blue Clay</i>	<i>60</i>	<i>180</i>
<i>Good sand</i>	<i>180</i>	<i>216</i>

WELL LOCATION:

sec. *17* T. *3* S. R. *17* W.
12 miles *W* of *Poplarville*
(distance) (direction) (nearest town)

WELL PURPOSE: *live stock*
(home, irrigation, municipal, industrial)

WELL COMPLETION DATA:

- (1) diameter (inches) *2"*
- (2) total depth (feet) *216'*
- (3) static water level (feet) *105* below/above top of ground.
- (4) casing *galv.* (material) (depth)
- 2"* (size) if telescope see back.
- (5) screen *5'* (length) (depth to top)
- 2"* (size) *5. Steel* (material)
- (6) pump *1* (HP) *450 gpm* (yield gpm)
- electric* (type power)
- (7) electric log *no.* (yes or no)

CODED

(organization running log)

(8) how well bottom plugged *Johnson*
Back Pressure Valve


DRILLERS REMARKS:

DEC 14 1970

MISS. Bd. OF WATER SERVICE

If well telescopes please sketch and show depths.

GROUND LEVEL

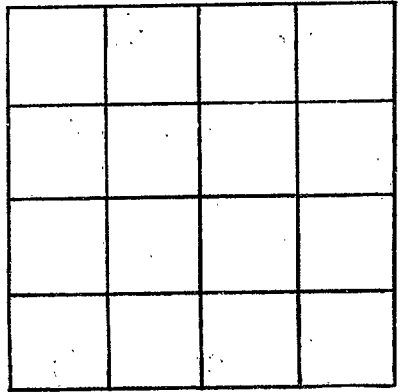

SECTION _____

Please indicate well location X.

ADDITIONAL INFORMATION

If more than one screen,
show locations of each on sketch.