

PEARL RIVER

K 38

11-21-70

MISSISSIPPI BOARD OF WATER COMMISSIONERS
416 North State Street
Jackson, Mississippi 39201

CODED

WATER WELL DRILLERS LOG

NEIL LUMPKIN WELL DRILLING SERVICE

P. O. BOX 117

CARRIERS, MISS.
firm name

Pearl River

county well located

11-21 1970
date well completed

LANDOWNER: James F. Jacks
Poplarville, Miss.
Box 432
(mailing address)

description of formations encountered

from to

Surface clay	0	20
✓ sand	20	60
Blue clay	60	95
Good sand	95	132

WELL LOCATION:

sec. 19 T. 3 S. R. 17 W.
6 miles NW of McNeil
(distance) (direction) (nearest town)

WELL PURPOSE: livestock
(home, irrigation, municipal, industrial)

WELL COMPLETION DATA:

- (1) diameter (inches) 2"
- (2) total depth (feet) 132'
- (3) static water level (feet) 60 below top of ground.
- (4) casing galv. (material), (depth) 2" (size) if telescope see back.
- (5) screen 5' (length), (depth to top) 2" (size), 5 Steel (material)
- (6) pump rod 200 gphr. (HP), (yield gpm) 3/4" gasoline motor (type power)
- (7) electric log No (yes or no)

No. 3

CODED

(organization running log)

(8) how well bottom plugged Johnson
back pressure valve


DRILLERS REMARKS:

DEC 14 1970

MISS. BD. OF WATER COMMISSIONERS

If well telescopes please sketch and show depths.

GROUND LEVEL

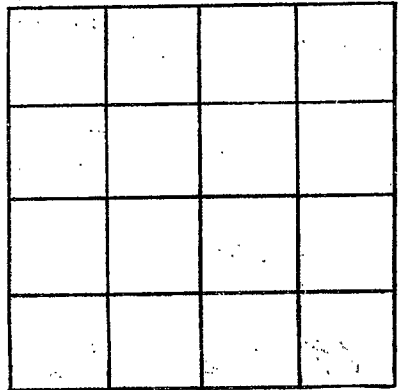

SECTION _____

Please indicate well location X.

ADDITIONAL INFORMATION

If more than one screen, show locations of each on sketch.