

PEARL RIVER

K41

11-27-70

MISSISSIPPI BOARD OF WATER COMMISSIONERS
416 North State Street
Jackson, Mississippi 39201

CODED

WATER WELL DRILLERS LOG

Nov. 27 1970 NEIL LUMPKIN WELL DRILLING SERVICE Pearl River
date well completed P. O. BOX 117
from CARRIERE, MISS. county well located

LANDOWNER: Bill Donacker Jr.

Joplarville, Miss.

Route (Whitesand)
(mailing address)

WELL LOCATION:

sec. 36 T. 3 S. R. 17 W.

8 miles NW of McNeil
(distance) (direction) (nearest town)

WELL PURPOSE: home
(home, irrigation, municipal, industrial)

WELL COMPLETION DATA:

(1) diameter (inches) 8 1/2" - 4" galv.
2 1/2" - 2" "

(2) total depth (feet) 221'

(3) static water level (feet) 19' below
top of ground. above

(4) casing galv.
(material) (depth)

_____ if telescope see back.
(size)

(5) screen 10'
(length) (depth to top)

2" 5. Steel
(size) (material)

(6) pump 1 1800 gpm.
(HP) (yield gpm)

Submersible
electric
(type power)

(7) electric log No.
(yes or no)

_____ (organization running log)

(8) how well bottom plugged Johnson
Pressure Valve

DRILLERS REMARKS:

description of formations encountered	from	to
<u>Surface Clay</u>	<u>0</u>	<u>60</u>
<u>Good Sand</u>	<u>100</u>	<u>110</u>
<u>Blue Clay</u>	<u>110</u>	<u>160</u>
<u>Fine to better Sand</u>	<u>160</u>	<u>221</u>


CODED

DEC 14 1970

MISS. BD. OF WATER COMM.

If well telescopes please sketch and show depths.

GROUND LEVEL

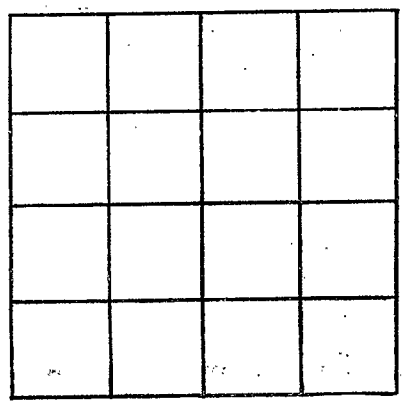

SECTION _____

Please indicate well location X.

ADDITIONAL INFORMATION

A series of horizontal lines for entering additional information.

If more than one screen, show locations of each on sketch.