

PEARL RIVER  
K42  
10-8-70

MISSISSIPPI  
BOARD OF WATER COMMISSIONERS  
416 North State Street  
Jackson, Mississippi 39201

**CODED**

WATER WELL DRILLERS LOG

10-8 1970 date well completed  
M. E. J. Water Well Serv. Pearl River firm name  
Pearl River county well located

LANDOWNER:

M. J. D. Ory  
Poplarville Miss.  
(mailing address)

description of formations encountered

	from	to
Red clay	0	15
med. white sd.	15	28
white clay	28	55
Blue clay	55	203
Grey congl. sd.	203	256

WELL LOCATION:

sec 25 T 3 N R 17 E  
5 miles East of Darby  
(distance) (direction) (nearest town)

WELL PURPOSE:

Home  
(home, irrigation, municipal, industrial)

WELL COMPLETION DATA:

- (1) diameter (inches)  $7\frac{1}{2}$  &  $4\frac{1}{2}$
- (2) total depth (feet) 256
- (3) static water level (feet) 81 below top of ground.
- (4) casing Color, 241  
(material) (depth)
- $4\frac{1}{2}$  if telescope see back.  
(size)
- (5) screen 10, 240  
(length) (depth to top)
- 2" 5.5  
(size) (material)
- (6) pump  $1\frac{1}{2}$  1600 gpm  
(HP) (yield gpm)
- Elect  
(type power)
- (7) electric log NO  
(yes or no)

**CODED**

(organization running log)

(8) how well bottom plugged 3/4


JAN 26 1971

DRILLERS REMARKS:

MISS. BD. OF  
WATER COMM.

If well telescopes please sketch and show depths.

GROUND LEVEL

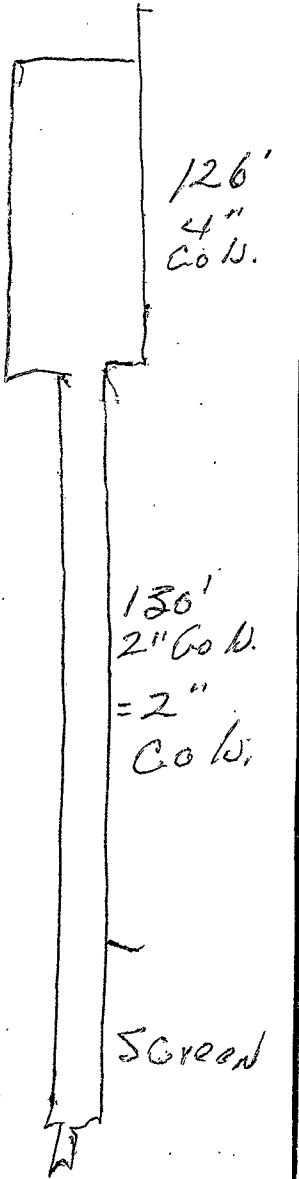

			X

SECTION 25

Please indicate well location X.

ADDITIONAL INFORMATION

If more than one screen,  
show locations of each on sketch.