

PEARL RIVER
K 43
12-23-70

MISSISSIPPI
 BOARD OF WATER COMMISSIONERS
 416 North State Street
 Jackson, Mississippi 39201

CODED

WATER WELL DRILLERS LOG

NEEL LUMPKIN WELL DRILLING SERVICE

P. O. BOX 117

Pearl River

12-23 1970
 date well completed

firm name CARRIERS, MISS.

county well located

LANDOWNER: Herford Feed
yards
902nd A. Dawson
Poplarville Route 3
 (mailing address)

description of formations encountered

from to

<u>white clay</u>	<u>0</u>	<u>60</u>
<u>blue clay</u>	<u>60</u>	<u>120</u>
<u>good, grey sand</u> <u>(fine to better)</u>	<u>120</u>	<u>179</u>

WELL LOCATION:

sec. 20 T. 3 S. R. 17 E.
 (distance) miles (direction) of (nearest town)
12 miles SW of Poplarville

WELL PURPOSE: feed lot
 (home, irrigation, municipal, industrial)

WELL COMPLETION DATA:

- diameter (inches) 4"
- total depth (feet) 179
- static water level (feet) 100 below above top of ground.
- casing galv. (material), (depth)
4" (size) If telescope see back.
- screen 10 (length), (depth to top)
2" (size) St. Steel (material)
- pump 3 (HP), 3600 (yield gpm) per hr.
electrical (type power)
- electric log no (yes or no)

CODED

(organization running log)

(8) how well bottom plugged Johnson
back pressure valve


FEB 2 1971

DRILLERS REMARKS:

MISS. Bd. of
 WATER COMMISSIONERS

If well telescopes please sketch and show depths.

GROUND LEVEL

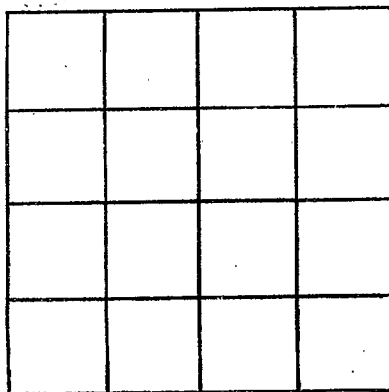

SECTION _____

Please indicate well location X.

ADDITIONAL INFORMATION

If more than one screen, show locations of each on sketch.