

PEARL RIVER
K 44
12-30-70

MISSISSIPPI
BOARD OF WATER COMMISSIONERS
416 North State Street
Jackson, Mississippi 39201

CODED

WATER WELL DRILLERS LOG

Dec. 30, 1970 NEIL LUMPKIN WELL DRILLING SERVICE Pearl River
date well completed firm name county well located

LANDOWNER:	description of formations encountered	from	to
James P. Jacobs Poplarville, Ms. 39470 (mailing address)	Surface clay	0	10
	Surface sand, no good	10	30
	Red clay	30	50
	Sand-buxty, no good	50	250
	Blue clay	250	290
	Good sand	290	337

LANDOWNER: James P. Jacobs
Poplarville, Ms.
39470
(mailing address)

WELL LOCATION:
sec. 16 T 3 S R 17 W
26 10 miles W of Poplarville
(distance) (direction) (nearest town)

WELL PURPOSE: Feed lot
(home, irrigation, municipal, industrial)
feeding stock

- WELL COMPLETION DATA:
- (1) diameter (inches) 2"
 - (2) total depth (feet) 337
 - (3) static water level (feet) 60 below top of ground.
 - (4) casing galv. (material), (depth) 2" If telescope see back. (size)
 - (5) screen 5' (length), (depth to top) 2" Stainless Steel (size), (material)
 - (6) pump 1 (HP) 650 gpm. (yield gpm) Electric (type power)
 - (7) electric log no (yes or no)

(organization running log)

(8) how well bottom plugged Johnson
rock pressure valve

DRILLERS REMARKS:


CODED

FEB 2 1971

MISS. BD. OF
WATER COMM.

If well telescopes please sketch and show depths.

GROUND LEVEL

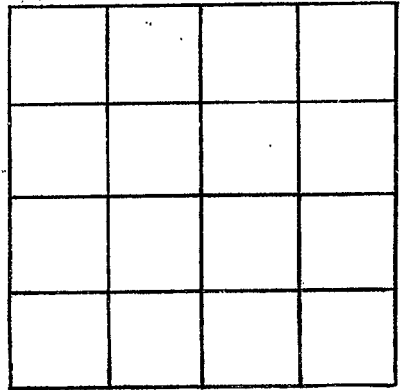

SECTION _____

Please indicate well location X.

ADDITIONAL INFORMATION

If more than one screen, show locations of each on sketch.