

PEARL RIVER
K45
4-12-73

MISSISSIPPI
 BOARD OF WATER COMMISSIONERS
 416 North State Street
 Jackson, Mississippi 39201

Pls. for info
 4/20/73

WATER WELL DRILLERS LOG

CODED

4/12 1973 date well completed
 Sumpkin Well Dr. firm name
 Pearl River county well located

LANDOWNER: *Mrs. Wyhaman*
Papillonville, Miss
 (mailing address)

description of formations encountered	from	to
Surface Clay	0	40
Sand	40	55
Clay	55	85
Sand	85	200
Clay	200	225
Sand	225	265
Clay	265	335
Sand	335	350
Clay	350	390
Sand	390	445

WELL LOCATION:
 sec. 35 T N R E
9 miles SW of Papillonville
 (distance) (direction) (nearest town)

WELL PURPOSE:
 (home, irrigation, municipal, industrial)

WELL COMPLETION DATA:

(1) diameter (inches) 2"

(2) total depth (feet) 445'

(3) static water level (feet) 100' below top of ground.

(4) casing Gal. 445'
 (material) (depth)

_____ if telescope see back.
 (size)

(5) screen 10' S. Steel
 (length) (depth to top)

2" 5 Steel
 (size) (material)

(6) pump 1 550hr
 (HP) (yield gpm)

Elco
 (type power)

(7) electric log _____
 (yes or no)

_____ (organization running log)

(8) how well bottom plugged BW


CODED

DRILLERS REMARKS:

(MSD 921) 7/3/73

If well telescopes please sketch and show depths.

GROUND LEVEL

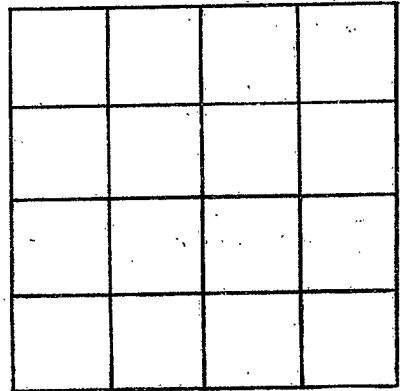

SECTION _____

Please indicate well location X.

ADDITIONAL INFORMATION

If more than one screen, show locations of each on sketch.