

PEARL RIVER
K 46
5-26-73

MISSISSIPPI
BOARD OF WATER COMMISSIONERS
416 North State Street
Jackson, Mississippi 39201

CODED

WATER WELL DRILLERS LOG

5-26 1973 HORACE A POOLE Pearl River
date well completed firm name county well located

| LANDOWNER: <u>MACCELL DUNCAN</u> | description of formations encountered | from | to |
|--|---------------------------------------|-----------|-----------|
| <u>RT # 3</u> | <u>SANDY CLAY</u> | <u>0</u> | <u>18</u> |
| <u>POPLARVILLE MISS</u> (mailing address) | <u>SAND + PEACOCK</u> | <u>18</u> | <u>42</u> |

WELL LOCATION:
sec. 24 T 3 N R. 17 E
S W
_____ miles _____ of _____
(distance) (direction) (nearest town)

WELL PURPOSE: Home
(home, irrigation, municipal, industrial)

- WELL COMPLETION DATA:
- (1) diameter (inches) 4 1/2
 - (2) total depth (feet) 42'
 - (3) static water level (feet) 20' below top of ground.
 - (4) casing Pvc, 37' (material), (depth)
2" if telescope see back. (size)
 - (5) screen 5, 37 (length), (depth to top)
2x5, Pvc (size), (material)
 - (6) pump 1/2, 6 (HP), (yield gpm)
Class (type power)
 - (7) electric log No (yes or no)
- _____
(organization running log)
- (8) how well bottom plugged BACK WASH UNPLUG


CODED

DRILLERS REMARKS: _____

JUN 29 1973

If well telescopes please sketch and show depths.

GROUND LEVEL

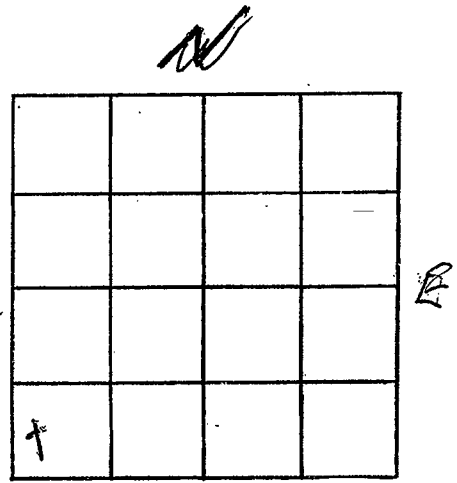

SECTION 24

Please indicate well location X.

ADDITIONAL INFORMATION

If more than one screen, show locations of each on sketch.