

PEARL RIVER
K 47
6-3-73

MISSISSIPPI
BOARD OF WATER COMMISSIONERS
416 North State Street
Jackson, Mississippi 39201

CODED

WATER WELL DRILLERS LOG

6-3-1973 date well completed
W. H. HARRIS & A. POOLE firm name
PEARL RIVER county well located

LANDOWNER: Donald Spiers
RT # 1
CARRIERE
(mailing address)

description of formations encountered	from	to
SANDY CLAY	0	10
CLAY	10	20
SAND	20	25
CLAY	25	147
SILT & CLAY	147	168
SAND	168	190

WELL LOCATION:
sec. 1 T. 3 S. R. 17 W.
14 miles S of Poplarville
(distance) (direction) (nearest town)

WELL PURPOSE: Home
(home, irrigation, municipal, industrial)

- WELL COMPLETION DATA:
- (1) diameter (inches) 4 1/2
 - (2) total depth (feet) 190'
 - (3) static water level (feet) 27' below above top of ground.
 - (4) casing PVC 180
(material) (depth)
2" if telescope see back.
(size)
 - (5) screen 10' 180
(length) (depth to top)
2 PVC
(size) (material)
 - (6) pump 1' 6
(HP) (yield gpm)
Elec
(type power)
 - (7) electric log NO
(yes or no)
- (organization running log)
- (8) how well bottom plugged BACKWASH VALVE


CODED

DRILLERS REMARKS:

JUN 29 1973

If well telescopes please sketch and show depths.

GROUND LEVEL

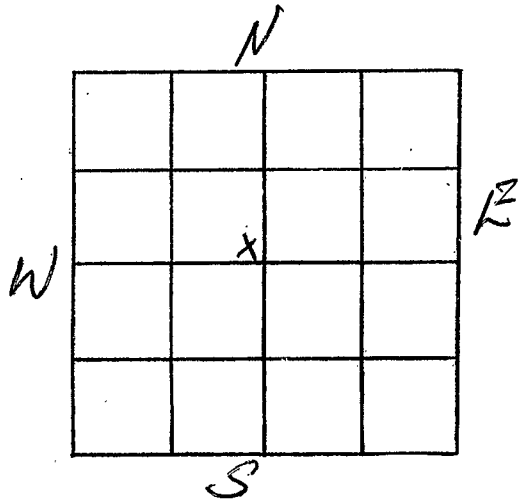

SECTION 1

Please indicate well location X.

ADDITIONAL INFORMATION

If more than one screen, show locations of each on sketch.