

Pearl River  
K 48  
7-16-73

MISSISSIPPI  
BOARD OF WATER COMMISSIONER  
416 North State Street  
Jackson, Mississippi 39201

**CODED**

WATER WELL DRILLERS LOG

July-16 1973 Lumpkin Well Sec. Pearl River  
date well completed firm name county well located

LANDOWNER: Mr. Vanderford  
66 Chester Home Builders  
New Orleans, La.  
(mailing address)

description of formations encountered	from	to
<u>CLAY</u>	<u>0</u>	<u>15</u>
<u>Sand</u>	<u>15</u>	<u>55</u>
<u>CLAY</u>	<u>55</u>	<u>100</u>
<u>Sand</u>	<u>100</u>	<u>151</u>

WELL LOCATION:  
sec. 17 T. 3 N. R. 17 E.  
11 miles W. of POPLARVILLE  
(distance) (direction) (nearest town)

WELL PURPOSE: Home  
(home, irrigation, municipal, industrial)

WELL COMPLETION DATA:

(1) diameter (inches) 4"

(2) total depth (feet) 150

(3) static water level (feet) 125 below top of ground.

(4) casing P.V.C., 140  
(material) (depth)  
no If telescope see back.  
(size)

(5) screen 10', 140  
(length) (depth to top)  
4", P.V.C.  
(size) (material)

(6) pump 1-SUB., 20  
(HP) (yield gpm)  
elec  
(type power)

(7) electric log No.  
(yes or no)

(organization running log)

(8) how well bottom plugged Paul Shub.


**CODED**

DRILLERS REMARKS:

JUL 27 1973

If well telescopes please sketch and show depths.

GROUND LEVEL

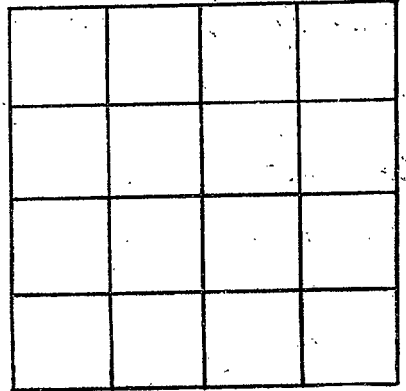

SECTION \_\_\_\_\_

Please indicate well location X.

ADDITIONAL INFORMATION

If more than one screen,  
show locations of each on sketch.