

P. R.
K 51
10-17-73

MISSISSIPPI
BOARD OF WATER COMMISSIONERS
416 North State Street
Jackson, Mississippi 39201 CODED

WATER WELL DRILLERS LOG

10-17-73 date well completed
Easley Stafford water well, firm name
Pearl River county well located

LANDOWNER: Ronnie H Smith
RT-3
Poplarville Miss
(mailing address)

description of formations encountered	from	to
Top soil	0	18
Chalk	18	52

WELL LOCATION:
sec. 1 T. 3 N. R. 17 E.
3 miles South of Land
(distance) (direction) (nearest town)

Sand & Gravel	52	87
---------------	----	----

WELL PURPOSE:
(home, irrigation, municipal, industrial)

WELL COMPLETION DATA:

(1) diameter (inches) 4

(2) total depth (feet) 87

(3) static water level (feet) 12 below above top of ground.

(4) casing 4 77
(material) (depth)
4 If telescope see back.
(size)

(5) screen 10 77
(length) (depth to top)
4 Plastic
(size) (material)

(6) pump 1/2 HP 10
(HP) (yield gpm)
Chc
(type power)

(7) electric log yes
(yes or no)

(organization running log)

(8) how well bottom plugged B. 2/3

CODED


NOV 29 1973

DRILLERS REMARKS:
Cleve Duncan

MISS. BD. OF
WATER COMM.

If well telescopes please sketch and show depths.

GROUND LEVEL

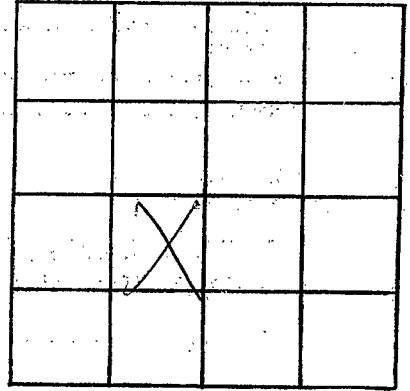

SECTION 1

Please indicate well location X.

ADDITIONAL INFORMATION

If more than one screen,
show locations of each on sketch.